
FORM 51 25M 8-50 WESTERN Barton KANSAS

Section 31 Township 16 Range 12W

Well No. #2 Klug

Company C. L. Carlock

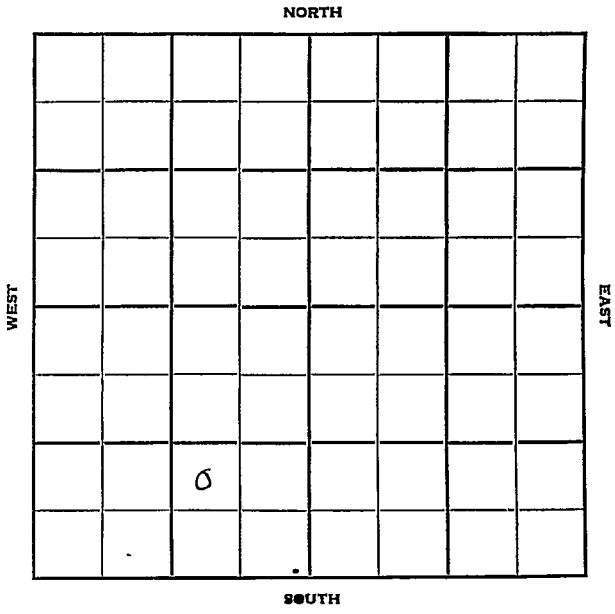

FORM 252-B
10M 10-50 PETROL

Barton KANSAS

Sec. 31 Twp. 16 R. 12W

Well No. #2 Klug Farm

C. L. Carlock Company

Murfin Drlg. - Contr. Contractor

Ainsworth Pool


____ Ft. from N. Line

990' Ft. from S. Line

990' Ft. from E. Line

____ Ft. from W. Line

NW SE SW

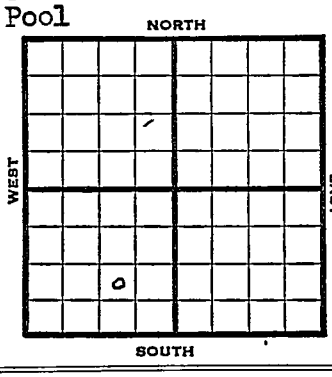

1950	Elev. 1953 REPORT
11/29	Location
1951 1/31	Spud 11/28/50 Oil well TD 3430 8" @168 Top. 2793 Heeb. 3076 Br. lime 3164 Lans. 3181 Arb. 3421-23 5" @3422 TD 3430 24/ 3309-14 1000 A 1 boph SP 3220 12/ 3199-3204 13/3209-14 1000 A 2 boph SP 3190 24/3182-86 FU 500' oil ½ hr. 4000 A S/ 5 boph Comp. 19 bopd

COMPLETED

FORM 275 FOR SALE BY KANSAS BLUE PRINT CO.


County Barton State Kansas

Sec. 31 (Blk. Twp.) 16 (Sur. Rge.) 12W Map No.

Operator C. L. Carlock

Well No. 2 Farm Klug

Elev. Location NW SE SW

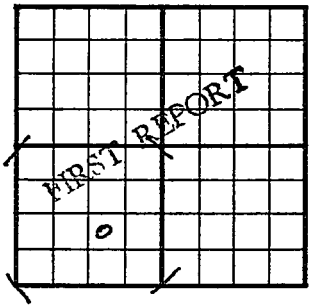

990 Ft. From S Line SW

990 Ft. From E Line Quarter

1st. Report NOV 2 9 1950

Completion

Remarks Murfin Drlg. - Contr.

Spudding Date 11-28-50

Drlg. Data Ainsworth Pool

Location

J. E. TYRA

FORM 275 FOR SALE BY KANSAS BLUE PRINT CO.


County Barton State Kansas

Sec. 31 (Blk. Twp.) 16 (Sur. Rge.) 12W Map No.

Operator C. L. Carlock

Well No. 2 Farm Klug

Elev. 1953 Location NW SE SW

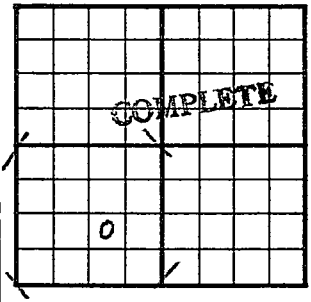

990 Ft. From S Line SW

990 Ft. From E Line Quarter

1st. Report

Completion JAN 31 1951

Remarks Ainsworth Pool

Murfin Drlg. - Contr.

Spudding Date 11-28-50

Drlg. Data Oil well TD 3430

8" @ 168 Top. 2793 Heeb. 3076

Br. lime 3164 Lans. 3181 Arb. 3421-23

5" @ 3422 TD 3430 24/ 3309-14 1000 A

1 boph SP 3220 12/ 3199-3204

12/ 3209-14 1000 A 2 boph SP 3190

24/ 3182-86 FU 500' oil ½ hr. 4000 A

S/ 5 boph Comp. 19 bopd

J. E. TYRA