

Sec. 2 Twp. 12 R. 15 W

Well No. # 1 Shaffer Farm

D. R. Lauck Company

Lauck Contractor


330 Ft. from N. Line

Ft. from S. Line

330 Ft. from E. Line

Ft. from W. Line

NE NE SW

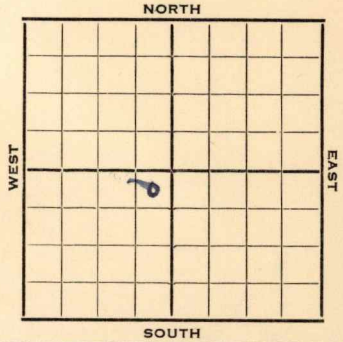

1952

Elev. 1773'

REPORT

9/24

Spud 9-20-52
8" @ 200

Drlg. 1740'

10/1

Topeka 2634, Heeb 2882, Tor 2904,
KC 2935-SSO, Arb 3238-42 RTD
5" @ 3239

10/8

Drlg. deeper 3250 TD 500A
S/8 BOPH, testing

10/15

"

10/22

S/10 BOPH for 5 hrs., POP

10/29

NR

~~11/5~~

~~8" @ 123' " ERROR "~~
~~Anhy 817'~~
~~Drlg. 2677'~~

11/5

Spud 9-20-52
Oil well TD 3250' 8" @ 200'
Top 2634', Heeb 2882', Tor. 2904',
KC 2935', Arb. 3238'
TD 3242' 5" @ 3239' DD 3250'
500 A S/8 BOPD S/10 BOPH
Comp. 141 BOPD

COMPLETED

