


Section 8 Township 15 Range 13-W

Well No. 14 Detrick (Twin #3)

Company Carter Oil

NORTH Coralena pool

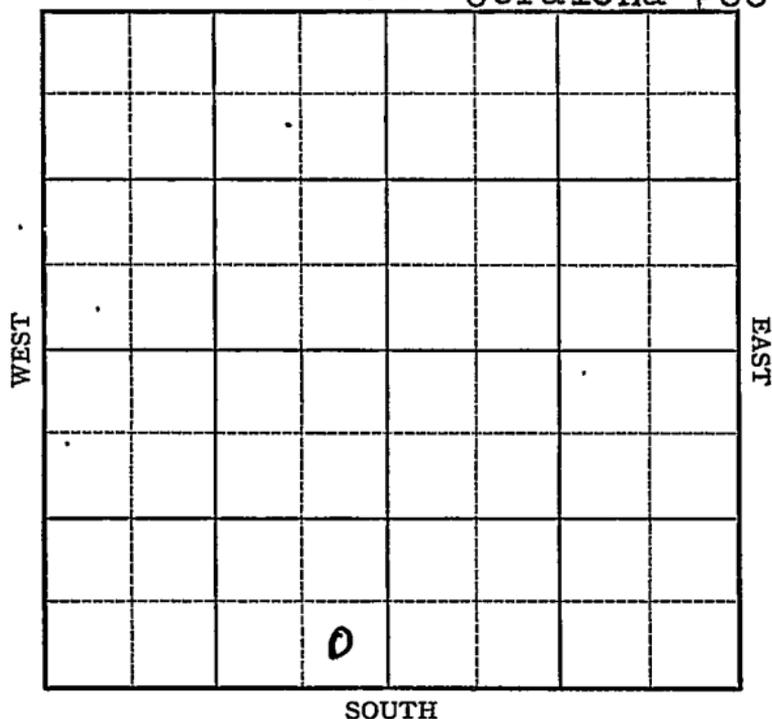

Sec. 8 Twp. 15 R. 13-W

Well No. #14 Detrich (Twin #3) Farm

Carter Oil Company
(Coralena)


_____ Ft. from N. Line

330 Ft. from S. Line

380 Ft. from E. Line

_____ Ft. from W. Line

Elev. 1749

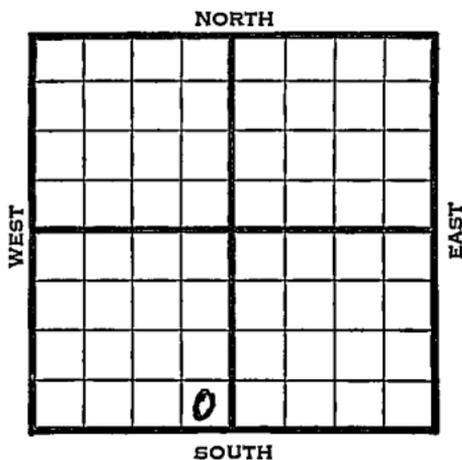

1941	REPORT
5/27	Location
6/5	8" - 223' Drlg. 2750'
6/12	Lans. 2902' 5" - 2905'
	T.D. 2949' 1700' oil
	1000 acid.
6/19	Pump 10 bbls. per hour.
6/26	Pump 208 oil 8 hours.
7/3	" " " "
7/10	" " " "
7/16	Lans. 2902'
	5" - 2905'
	T.D. 2949'
	10,000 acid.
	Potential 625 bbls., pump.
	39. Gravity
	COMPLETED

Map No. 73 Sec. 8 Twp. 15 R. 13WWell No. 14 Detrich (Twin #3)Carter Oil Company**FIRST REPORT** Contractor

SE SW

 Ft. from N. Line330 Ft. from S. Line380 Ft. from E. Line Ft. from W. Line

CORALENA POOL

SECTION PLAT

Location XRig up

Drilling and Remarks:

RECORD

Cased in., ft.Sand Gas Oil Total Depth

PRODUCTION

1st 24 hrs. Nat. 1st 24 hrs. after shot Gas Cu. Ft.Dry Hole Abandoned

Date

MAY 27 1941S. J. LEWIS Scout

