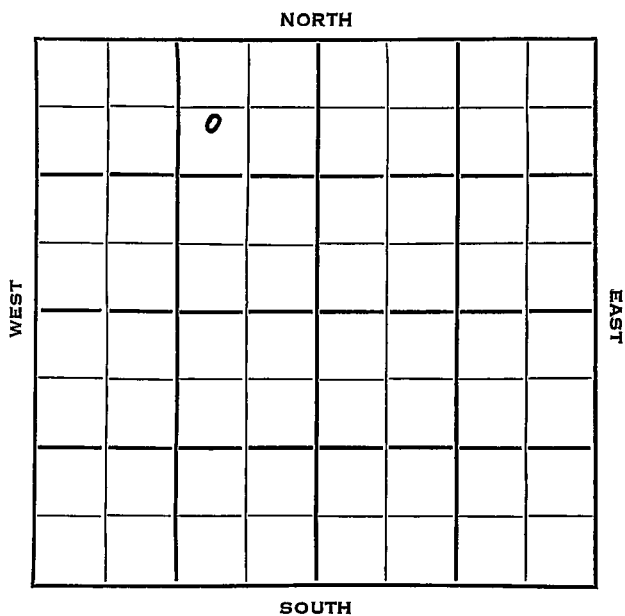


Section 8 Township 15 Range 13WWell No. 15 Geo. ReinCompany Skelly Oil

KANSAS

WELL NO

FARM

COMPANY

Skelly Oil

CONTRACTOR

Wentworth

Trapp Pool

NORTH


760 Ft from N Line

Ft from S Line

990 _____ Ft from E Line

Ft from W Line

SW NE NW

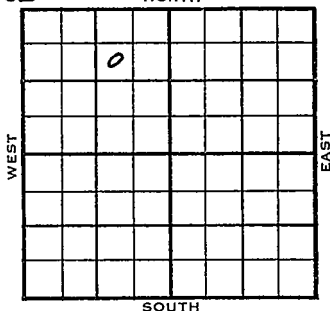

1954	1755'	REPORT
------	-------	--------

4/21	Spud 4-19-54
	Drlg 90'

5/19 Spud 4-19-54 Oil well TD 3208'
Anhy 720 7" @ 730 Indian Cave 2291
Tarkio 2353 Top. 2621 Heeb 2852
Tor. 2868 Doug. 2885' Lans 2918
Arb. 3197' TD 3200 5" @ 3198
DD 3208 P/128 BO 6 hr. P/242 BO
12 hr. Comp.

COMPLETED

County **Russell** State **Kansas**

Sec. 8 (Blk Twp) 15 (Sur. Rge) 13W Map No.

Operator **Skelly Oil**

Well No. **15** Farm **Geo. Rein**

Elev.	Location	SW	NE	NW
-------	----------	----	----	----

0

FIRST REPORT

760 Ft. From N Line NW

990 Ft. From E Line Quarter

1st Report APR 21 1954

1st. Report

Completion

Remarks

Wentworth - Contr.

Spudding Date **4-19-54**

Drlg. Data Trapp Pool

drlg. 90

J. G. McGEHEE

County Russell State KansasSec. 8 (Blk
Twp) 15 (Sur.
Rge) 13W Map No.Operator Skelly OilWell No. 15 Farm Geo. ReinElev. 1755 Location SW NE NW

		0					

760 Ft. From N Line NW990 Ft. From E Line Quarter

1st. Report

Completion MAY 19 1954Remarks Trapp PoolWentworth - Contr.Spudding Date 4-19-54Drlg. Data Oil well TD 3208Anhy 720 7" @ 730 Indian Cave 2291Tarkio 2353 Top. 2621 Heeb. 2852Tor. 2868 Doug. 2885 Lans. 2918Arb. 3197 TD 3200 5" @ 3198 DD 3208P/ 128 bo 6 hr. P/ 242 bo 12 hr.Comp.

J. G. McGEHEE