

~~KANSAS~~ KANSAS


Russell

FORM 51 5M PETROL

Section 5 Township 12 Range 15W

Well No. #8 R. Kollman

Company T.C. Johnson Est.  
Fairport Pool

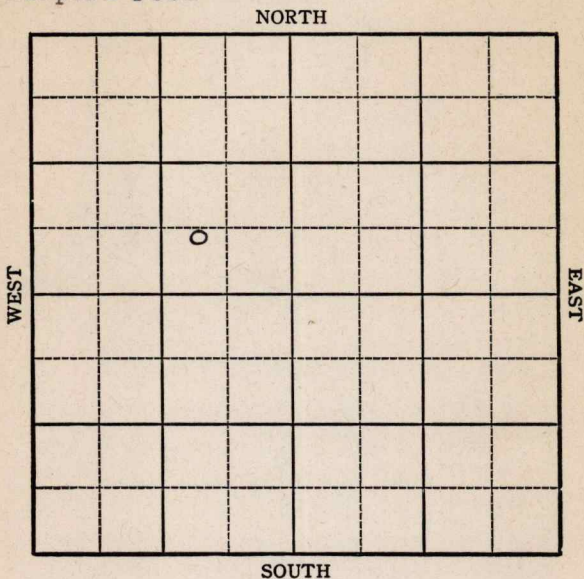

Sec. 5 Twp. 12 R. 15-W

Well No. # 8 R. Kollman Farm

T. C. Johnson Est. Company


C W L SE NW

\_\_\_\_\_ Ft. from N. Line

610 Ft. from S. Line

990 Ft. from E. Line

\_\_\_\_\_ Ft. from W. Line

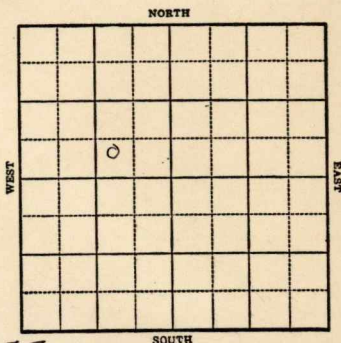

Elev. 1677

1943

R E P O R T

- 12-29 Rotary  
All Wells abandoned on this quarter.
- 1944
- 1-5 **Anhy 716**  
TD 736 Run Pipe
- 1-12 **Anhy 738 corrected 1723**  
**8" @ 721'**
- 1/19 Drlg. 2055'
- 1/26 **Lans 2757**  
Drlg. 2959 SO
- 2/2 **Reagan 3066-71TD Sat**  
**5" @ 3062**  
Rust
- 2/8 "
- 2/15 **B. Sand 3073-1/2 bailer oil per hr.**  
**Quartzite 3379 TD**
- 2/23 TD 3088  
SD
- 3/3 **Lans 2757**  
**Reagan 3066**  
**Quartzite 3079**  
**TD 3088'**  
**5" @ 3062**  
36 shots to 2959-96  
2000 acid  
Pump 200Pot.  
Gravity 39

**COMPLETED**

KANSAS

Map No. 72 Sec. 5 Twp. 12 R. 15W

Well No. 8 R. Kollman

T. C. Johnson Est. Company

FIRST REPORT Contractor

C W L SE NW

SECTION PLAT

\_\_\_\_\_ Ft. from N. Line  
610 Ft. from S. Line  
990 Ft. from E. Line  
\_\_\_\_\_ Ft. from W. Line

	o		

Fairport Pool

Location \_\_\_\_\_

Rig up \_\_\_\_\_

Drilling and Remarks:

Rotary  
All wells  
abandoned on  
this quarter

RECORD

Cased \_\_\_\_\_ in., \_\_\_\_\_ ft.  
Sand \_\_\_\_\_  
Gas \_\_\_\_\_  
Oil \_\_\_\_\_  
Total Depth \_\_\_\_\_

PRODUCTION

1st 24 hrs. Nat. \_\_\_\_\_  
1st 24 hrs. after shot \_\_\_\_\_  
Gas \_\_\_\_\_ Cu. Ft.  
Dry Hole \_\_\_\_\_  
Abandoned \_\_\_\_\_

Date

DEC 29 1943

19

S. J. LEWIS

Scout

Map No. 72 **KANSAS** Sec. 5 Twp. 12 R. 15 W

Well No. 8 R. Kollman

T. C. Johnson Est. Company

**COMPLETED**

Contractor

**C W L SE NW**

**SECTION PLAT**

\_\_\_\_\_ Ft. from N. Line

610 Ft. from S. Line

990 Ft. from E. Line

\_\_\_\_\_ Ft. from W. Line

	o		

**Fairport Pool**

Location \_\_\_\_\_

Rig up \_\_\_\_\_

Drilling and Remarks:

*Lean 2357  
 Reagan 3066  
 2 hrs to 3079  
 5" C 3062  
 36.2 hrs to 2955-96  
 2000 acid  
 Pump 200 P.T.  
 39 1/2*

**RECORD**

Cased \_\_\_\_\_ in., \_\_\_\_\_ ft.

Sand \_\_\_\_\_

Gas \_\_\_\_\_

Oil \_\_\_\_\_

Total Depth 3088

**PRODUCTION**

1st 24 hrs. Nat. \_\_\_\_\_

1st 24 hrs. after shot \_\_\_\_\_

Gas \_\_\_\_\_ Cu. Ft.

Dry Hole \_\_\_\_\_

Abandoned \_\_\_\_\_

Date

MAR 1 1944 19

S. J. LEWIS Scout