


Section 8 Township 15 Range 13-W

Well No. 9 Detrick

Company Carter Oil

NORTH Coralena Pool

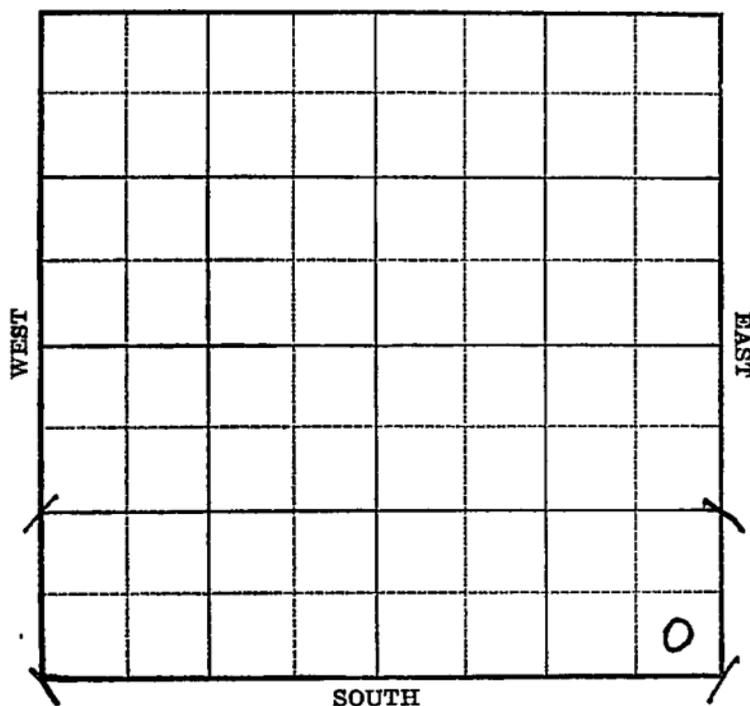

KANSAS

Russell

Sec. 8 Twp. 15 R. 13-WWell No. #9 Detrick FarmCarter Oil Company


(Coralena)

_____ Ft. from N. Line

330 Ft. from S. Line330 Ft. from E. Line

_____ Ft. from W. Line

Elev. 1881

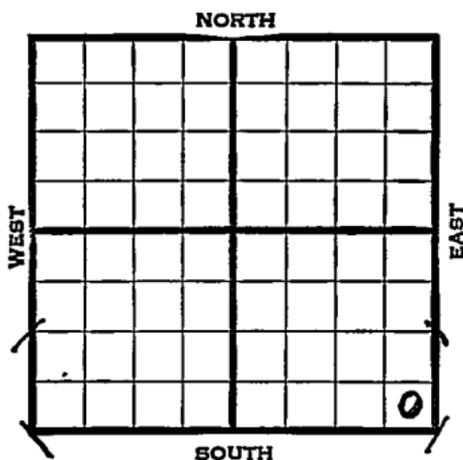

1939	REPORT
5/24	Location
6/1	10" - 245' Drlg. 1006'
6/8	Anhy 859' Drlg. 3030'
6/16	Lans. 3046 ³⁰⁵⁵ ' Good show oil 3074-3236' Arb. 3375' T.D. 3388'
	Show water.
6/23	4½" - 3202'
	30 shots 3070½-3073'
	78 shots 3082-97'
	5000 acid. Swab 30 bbls. per hr.
6/29	Lans. 3055' (Corrected)
	Swab 15 bbls. per hr for 8 hrs.
7/6	Shut down.
7/13	Pump 11 bbls. per hr. 2 hrs.
7/19	Lans. 3055'
	4½" - 3202'
	T.D. 3385'
	78 shots.
	Depthograph potential 110 bbls.
	COMPLETED

Russell

KANSAS

Map No. 73 Sec. 8 Twp. 15 R. 13WWell No. 9 DetrickCarter Oil

Company

Contractor

FIRST REPORT

SE/C

SECTION PLAT

 Ft. from N. Line330 Ft. from S. Line330 Ft. from E. Line Ft. from W. Line

CORALENA POOL

Location X

RECORD

Rig up

Drilling and Remarks:

Cased in., ft.Sand Gas Oil Total Depth

PRODUCTION

1st 24 hrs. Nat. 1st 24 hrs. after shot Gas Cu. Ft.Dry Hole Abandoned

Date

MAY 24 1939 19S. J. LEWIS Scout

Map No. 73 Sec. 8 Twp. 15 R. 13W

Well No. 9 Detrick

Carter Oil Company

Contractor

COMPLETED
SE/C

SECTION PLAT

_____ Ft. from N. Line
330 Ft. from S. Line
330 Ft. from E. Line
_____ Ft. from W. Line

CORALENA POOL

Location _____

Rig up _____

Drilling and Remarks:

Loss 8055
4 1/2" @ 3202
78 Blots
Depthograph
110

RECORD

Cased _____ in., _____ ft.
Sand _____
Gas _____
Oil _____
Total Depth 3385

PRODUCTION

1st 24 hrs. Nat. _____
1st 24 hrs. after shot _____
Gas _____ Cu. Ft.
Dry Hole _____
Abandoned _____

Date

JUL 19 1933 19

S. J. LEWIS Scout