


Section 5 Township 12 Range 15W

Well No. #9, Kallman twin #5

Company T.C. Johnson est.

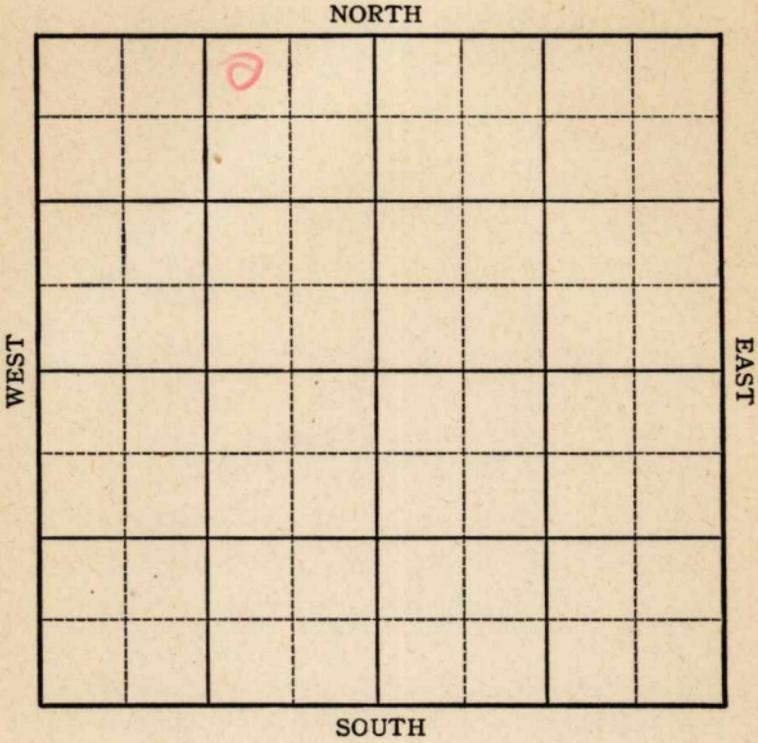

**KANSAS**

Sec. 5 Twp. 12 R. 15W

Well No. #9 Kollman twin #5 Farm

T. C. Johnson Est. Company

Fairport


330 Ft. from N. Line

\_\_\_\_\_ Ft. from S. Line

990 Ft. from E. Line

\_\_\_\_\_ Ft. from W. Line

NW NE NW

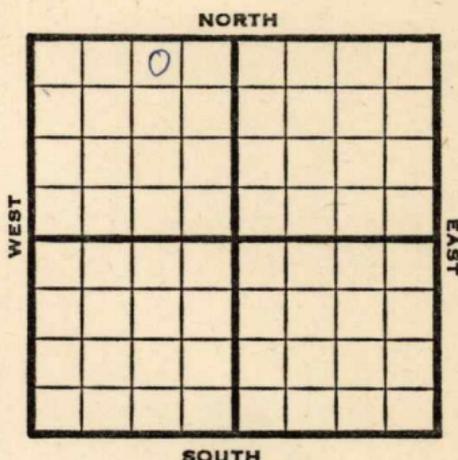

1946

REPORT

**Elev. 1733**

3/27 RUR.

4/4 Anhy. 768

8" @ 777

Drlg. 1735

4/10 **Topeka 2687**

**Lans 2881**

Drlg 2965

4/16 **Arb 3124**

TD 3136

4/23 5" @ 31125-1700' oil 1 hr

5/1 **Arb. 3124**

5" @ 3125

TD 3138'

Pump 300 Pot.

Grav. 39.0

**COMPLETED**

**KANSAS**

Kansas Pool Name Fairport

Map No. 72 Sec. 5 Twp. 12 R. 15W

Well No. 9 Kollman twin #5

T. C. Johnson est. Company

**FIRST REPORT**

Contractor

NW NE NW

**SECTION PLAT**

330 Ft. from N. Line

\_\_\_\_\_ Ft. from S. Line

990 Ft. from E. Line

\_\_\_\_\_ Ft. from W. Line

	0		

**Russell County**

Location \_\_\_\_\_

Rig up \_\_\_\_\_

Drilling and Remarks:

RUR

**RECORD**

Cased \_\_\_\_\_ in., \_\_\_\_\_ ft.

Sand \_\_\_\_\_

Gas \_\_\_\_\_

Oil \_\_\_\_\_

Total Depth \_\_\_\_\_

**PRODUCTION**

1st 24 hrs. Nat. \_\_\_\_\_

1st 24 hrs. after shot \_\_\_\_\_

Gas \_\_\_\_\_ Cu. Ft.

Dry Hole \_\_\_\_\_

Abandoned \_\_\_\_\_

Date

MAR 27 1946

S. J. LEWIS

Scout

**KANSAS** Kansas Pool Name Fairport

Map No. 72 Sec. 5 Twp. 12 R. 15W

Well No. 9 Kollman twin #5

T. C. Johnson Est. Company

**COMPLETED**

Contractor

NW NE NW

*E 11733*  
SECTION PLAT

330 Ft. from N. Line

\_\_\_\_\_ Ft. from S. Line

990 Ft. from E. Line

\_\_\_\_\_ Ft. from W. Line

	0		

**Russell County**

**RECORD**

Location \_\_\_\_\_

Rig up \_\_\_\_\_

Drilling and Remarks:

*Art 83124*  
*5" @ 3125*  
*Pump. 300 Pst.*

*390/Gr*

Cased \_\_\_\_\_ in., \_\_\_\_\_ ft.

Sand \_\_\_\_\_

Gas \_\_\_\_\_

Oil \_\_\_\_\_

Total Depth 3125

**PRODUCTION**

1st 24 hrs. Nat. \_\_\_\_\_

1st 24 hrs. after shot \_\_\_\_\_

Gas \_\_\_\_\_ Cu. Ft.

Dry Hole \_\_\_\_\_

Abandoned \_\_\_\_\_

Date

MAY 1 1946 19

S. J. LEWIS Scout