


Section 8 Township 15 Range 13W

Well No. 11 M. E. Anderson

Company Skelly Oil

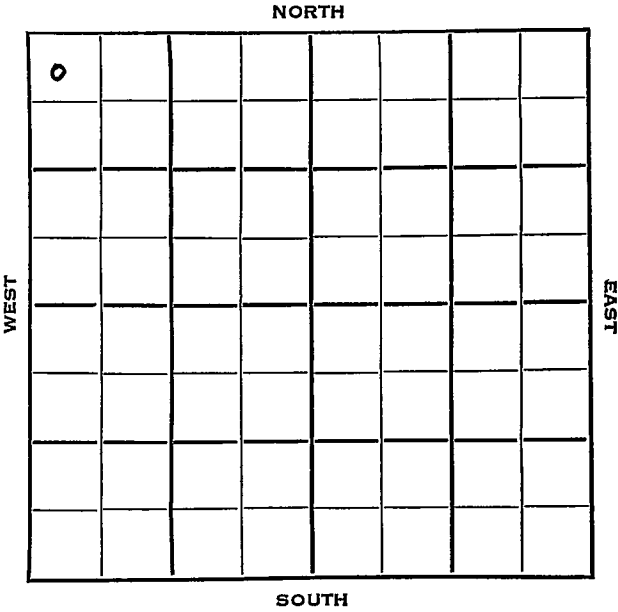

SEC	TWP	R
8	15	13 W ✓

WELL NO

11 M. E. Anderson

FARM

COMPANY

Skelly Oil

CONTRACTOR

Wentworth

Trapp Pool


330 Ft from N Line

Ft from S. Line

Ft. from E. Line

250 Ft from W. Line

NW NW NW

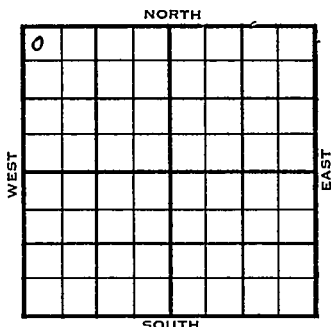

ELEVATION	REPORT
1954	1746'

2/24 Spud 2-21-54
Drlg.

3/3 Anhy 730 8" @ 740 Lans. 2932
Drlg. 2950'

3/17 Spud 2-21-54
Oil Well
TD 3220'
Anhy 730'
8" @ 740'
Lans 2932', Indian cave 2290', Tarkio
2354', Willard sh 2367', Top 2630',
Heeb 2861', Tor 2885', Lans 2932',
Arb. 3199'
TD 3220'
5 1/2" @ 3220'
CO to 3215
27/3208-11, 250A
P/77 bo 20 hrs.
P/29 bo 10 hrs.
Comp. 71 bopd

COMPLETED

County	Russell		State	Kansas	
Sec.	8	(Blk) (Twp)	15	(Sur.) (Rge)	13W	
Operator	Skelly Oil	
Well No.	11	Farm	M. E. Anderson	
Elev.	NW NW NW	
<table border="1"> <tr> <td>0</td> <td></td> <td></td> <td></td> <td></td> <td></td> </tr> <tr> <td></td> <td></td> <td></td> <td></td> <td></td> <td></td> </tr> <tr> <td></td> <td></td> <td></td> <td></td> <td></td> <td></td> </tr> <tr> <td></td> <td></td> <td></td> <td></td> <td></td> <td></td> </tr> <tr> <td></td> <td></td> <td></td> <td></td> <td></td> <td></td> </tr> <tr> <td></td> <td></td> <td></td> <td></td> <td></td> <td></td> </tr> <tr> <td></td> <td></td> <td></td> <td></td> <td></td> <td></td> </tr> <tr> <td></td> <td></td> <td></td> <td></td> <td></td> <td></td> </tr> </table>	0																																																330	Ft. From	N	Line	NW
	0	
	250	Ft. From	W	Line	Quarter	
	FEB 24 1954	
	1st. Report	
	Completion	
	Remarks	
	Wentworth - Contr.	
	Spudding Date	
	2-21-54	
	Trapp Pool	
Drlg. Data	
drlg.	

J. G. McGEHEE

County Russell State KansasSec. 8 (Blk. Twp.) 15 (Sur. Rge.) 13W Map No.Operator Skelly OilWell No. 11 Farm M. E. AndersonElev. 1746 Location NW NW NW

0						

COMPLETE330 Ft. From N Line NW250 Ft. From W Line Quarter1st. ReportCompletion MAR 17 1954Remarks Trapp PoolWentworth - Contr.Spudding Date 2-21-54Drlg. Data Oil well TD 3220Anhy 730 8" @ 740 Lans. 2932Indian cave 2290 Tarkio 2354 Willardsh. 2367 Top. 2630 Heeb. 2861Ter. 2885 Lans. 2932 Arb. 3199TD 3220 5½" @ 3220 CO to 321527/ 3208-11 250 A p/ 77 bo 20 hr.P/ 29 bo 10 hr. Comp. 71 bopd