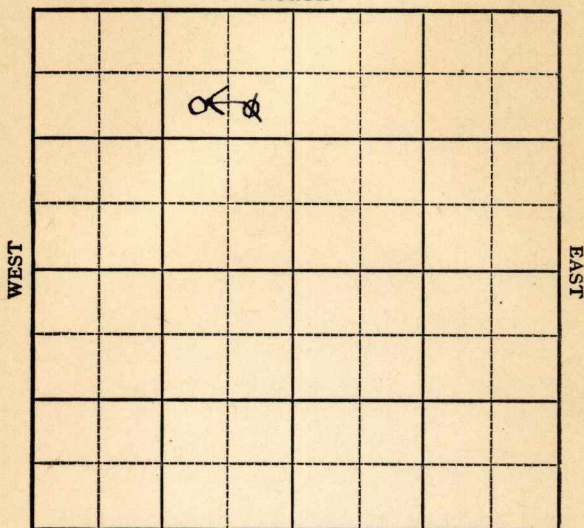


Section 5 Township 12 Range 15WWell No. 11 KollmanCompany T.C. Johnson Est.Fairport Pool  
NORTH

SOUTH

Russell

KANSAS

Sec. 5 Twp. 12 R. 15W

Well No. #11 Kollman Farm

T. C. Johnson Est. Company

Fairport Pool


990' Ft. from N. Line

         Ft. from S. Line

1010' Ft. from E. Line

         Ft. from W. Line

SW NE NW Twin

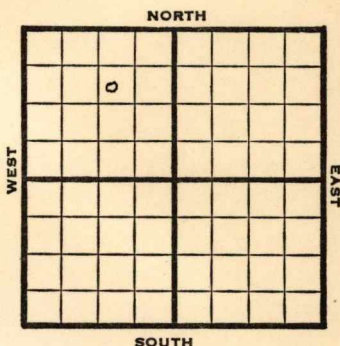

1948 Elev. 1704' REPORT

|       |                              |
|-------|------------------------------|
| 8/18  | 8" @ 750'                    |
|       | Drlg. 1770'                  |
| 8/25  | Lansing 2787                 |
|       | BKC 3065'                    |
|       | Sooy 3093'                   |
|       | Granite Wash 3104            |
|       | Granite 3148'                |
|       | TD 3149'                     |
|       | 5"@ 3148'                    |
| 9/1   | "                            |
| 9/8   | "                            |
| 9/14  | "                            |
| 9/21  | 24 shots 2089-94             |
|       | swb 5 bbls oil a day         |
| 9/29  | 30 shots 2998-3008 1000 acid |
| 10/6  | "                            |
| 10/13 | Lans. 2787'                  |
|       | Granite 3148'                |
|       | 5" @ 3148'                   |
|       | Perf Lans.                   |
|       | 1000 acid                    |
|       | Pump 20 oil Pot.             |
|       | Gr. 36°                      |
|       | TD 3149'                     |

COMPLETED

Russell County Kansas StateMap No. \_\_\_\_\_ Sec. 5 Twp. 12 R. 15WWell No. 11 KollmanT. C. Johnson Est. CompanyFIRST REPORT Contractor

SW NE NW

## SECTION PLAT

|  |  |  |  |  |  |  |  |
|--|--|--|--|--|--|--|--|
|  |  |  |  |  |  |  |  |
|  |  |  |  |  |  |  |  |
990 Ft. from N. Line

\_\_\_\_\_ Ft. from S. Line

1010 Ft. from E. Line

\_\_\_\_\_ Ft. from W. Line

Fairport Pool

Remarks:

twin well 8" @ 750 drlg. 1770

Date  
AUG 1 8 1948

Scout S. J. LEWIS


Map No. 72 Sec. 5 Twp. 12 R. 15WWell No. 11 KollmanT. C. Johnson Est.

Company

COMPLETE

Contractor

SW NE NW

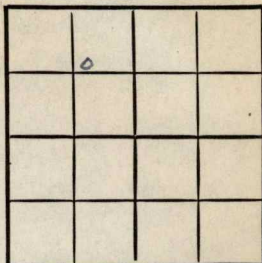E11704  
SECTION PLAT990 Ft. from N. Line       Ft. from S. Line1010 Ft. from E. Line       Ft. from W. LineRussell CountyLocation       Rig up       

Drilling and Remarks:

Lease 2787Granite 31485" C 3148Perf Lease.1600 acidPump 20 oil 1st  
26 2/3

## RECORD

Cased        in.,        ft.Sand       Gas       Oil       Total Depth 3147

## PRODUCTION

1st 24 hrs. Nat.       1st 24 hrs. after shot       Gas        Cu. Ft.Dry Hole       Abandoned       

Date

Oct 13 1948

19

S. J. LEWIS

Scout