

KANSAS


FORM 51 5M PETROL

Barton

Section 21 Township 16 Range 12W

Well No. #1 A. Klug

Company Magnolia

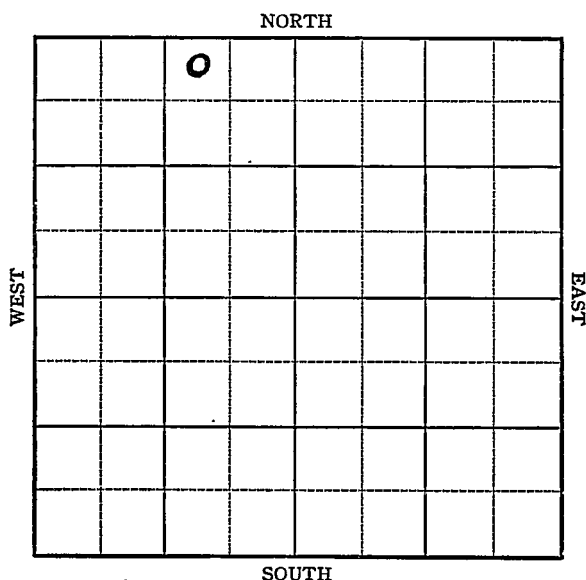

KANSAS

Barton

Sec. 31 Twp. 16 R. 12W

Well No. #1 A. Klug Farm

Magnolia Company


Reif

330 Ft. from N. Line

 Ft. from S. Line

990 Ft. from E. Line

 Ft. from W. Line

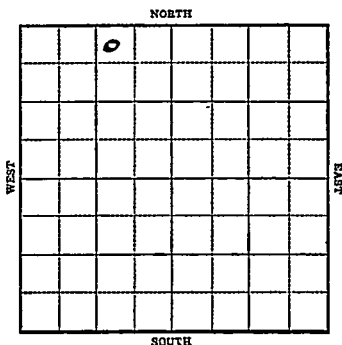

1944

R E P O R T

2/23 Derrick

3/1 10" @ 250
Drlg. 1000

3/8 Drlg. 3025

3/15 Lans 3150
Arb. 3442
TD 3465
No shows

ABANDONED

KANSAS

Map No. 55 Sec. 31 Twp. 16 R. 12WWell No. 1 A. KlugMagnolia

Company

FIRST REPORT

Contractor

NW NE NW


SECTION PLAT

330 Ft. from N. Line

Ft. from S. Line

990 Ft. from E. Line

Ft. from W. Line

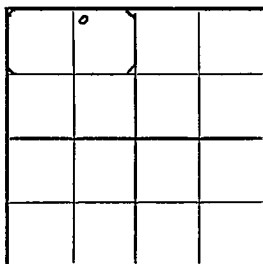Reif Pool

Location

Rig up

Drilling and Remarks:

Derrick

RECORD

Cased _____ in., _____ ft.

Sand _____

Gas _____

Oil _____

Total Depth _____

PRODUCTION

1st 24 hrs. Nat. _____

1st 24 hrs. after shot _____

Gas _____ Cu. Ft.

Dry Hole _____

Abandoned _____

Date

FEB 23 1944

19

S. J. LEWIS

Scout

KANSAS

Map No. 55 Sec. 31 Twp. 16 R. 12WWell No. 1 A. KlugMagnolia Company

ABANDONED

Contractor

NW NE NW

330

Ft. from N. Line

Ft. from S. Line

990

Ft. from E. Line

Ft. from W. Line

SECTION PLAT

	6		

Reif Pool

Location

Rig up

Drilling and Remarks:

*Loss 3150**Cr 3442**No show*

RECORD

Cased _____ in., _____ ft.

Sand _____

Gas _____

Oil _____

Total Depth *3465*

PRODUCTION

1st 24 hrs. Nat. _____

1st 24 hrs. after shot _____

Gas _____ Cu. Ft.

Dry Hole _____

Abandoned _____

Date

MAR 15 1944 19

S. J. L. Scout