


Section 8 Township 15 Range 13 W

Well No. # 1 Rein

Company Bennett & Roberts

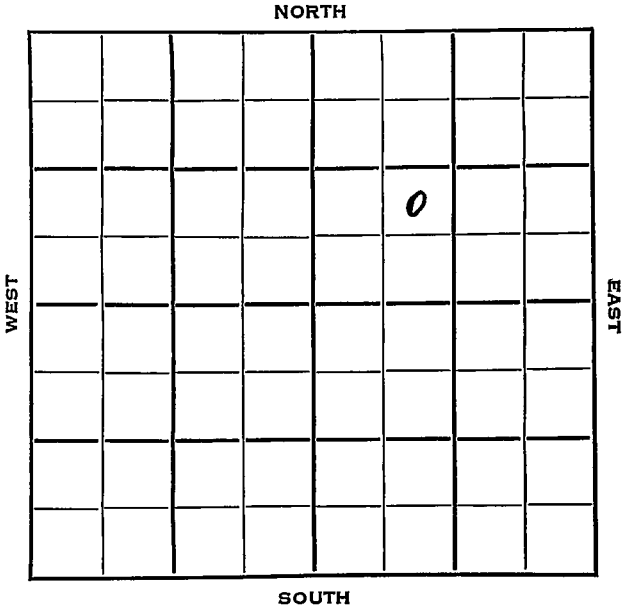

Sec. 8 Twp. 15 R. 13W

Well No. #1 Rein Farm

Bennett & Roberts. Company

B & R Drlg. Contractor


Trapp Pool

 Ft. from N. Line

990 Ft. from S. Line

 Ft. from E. Line

990 Ft. from W. Line

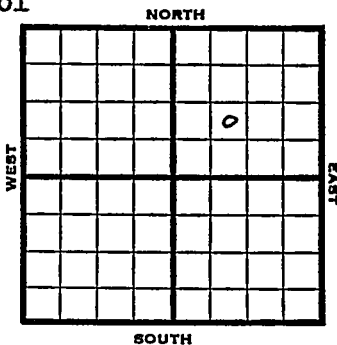

NE SW NE
Gulf farmout

1953 Elev. 1750' REPORT

6/3 MIR

6/10 8" @ 400'
Ø 2278-92 15'
Ø 2292-2309 17'
Drlg 2590'

6/24 Spud 6-2-53
D & A TD 3230 8" @ 400
Lans 2909 Arb. 3213
DST 3222-30 open 1 hr rec 30' oil
120' gas, 645' SW
TD 3230 D & A

ABANDONED

