


Section 31 Township 16 Range 12W

Well No. #1 H. Klug

Company N C R A

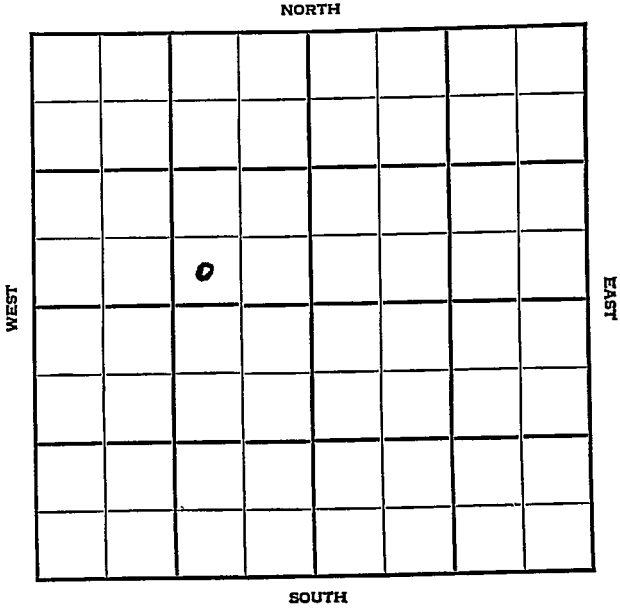

KANSAS

Barton



Sec. 31 Twp. 16 R. 12W

Well No. #1 H. Klug Farm

N C R A

Company

Wildcat


Ft. from N. Line

330' Ft. from S. Line

990' Ft. from E. Line

Ft. from W. Line

SW SE NW

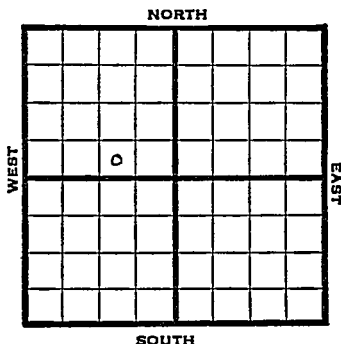

1948 Elev. 1954' REPORT

5/19 8-5/8" @ 245'  
Anhy. 870'  
Drlg. 2650'

5/26 Arbuckle 3331'  
TD 3334'  
5" @ 3332'  
RUST

6/1 "

6/9 Arb. 3431'  
5" @ 3432'  
TD 3450'  
Abd.

**ABANDONED**

Map No. \_\_\_\_\_ Sec. 31 Twp. 16 R. 12W

Well No. 1 H. Klug

N C R A \_\_\_\_\_ Company

FIRST REPORT \_\_\_\_\_ Contractor

SW SE NW

SECTION PLAT


\_\_\_\_\_ Ft. from N. Line

330 Ft. from S. Line

990 Ft. from E. Line

\_\_\_\_\_ Ft. from W. Line

Barton County

Location \_\_\_\_\_

Rig up \_\_\_\_\_

Drilling and Remarks:

8 5/8" @ 245

Anhy 870

drlg. 2650

RECORD

Cased \_\_\_\_\_ in., \_\_\_\_\_ ft.

Sand \_\_\_\_\_

Gas \_\_\_\_\_

Oil \_\_\_\_\_

Total Depth \_\_\_\_\_

PRODUCTION

1st 24 hrs. Nat. \_\_\_\_\_

1st 24 hrs. after shot \_\_\_\_\_

Gas \_\_\_\_\_ Cu. Ft.

Dry Hole \_\_\_\_\_

Abandoned \_\_\_\_\_

Date

MAY 19 1948 19

S. J. LEWIS Scout

