


Section 32 Township 16 Range 12-W

Well No. #1 Charles

Company Petroleum Inc.

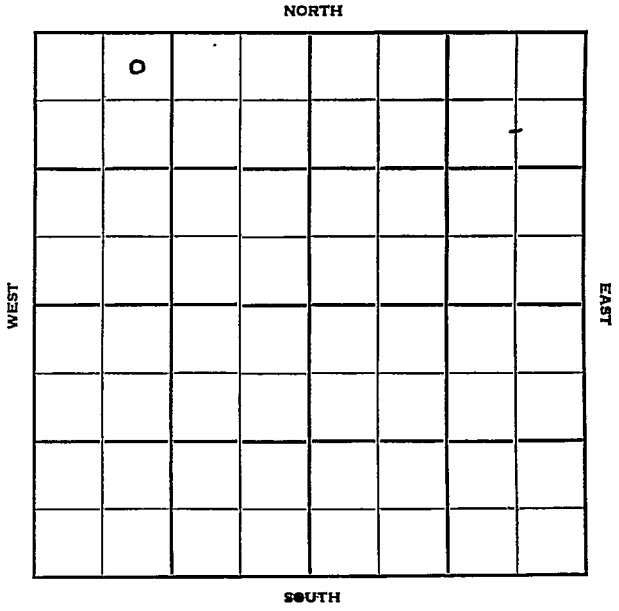

Barton KANSAS

Sec. 32 Twp. 16 R. 12W

Well No. #1 Charles Farm

Petroleum, Inc. Company

Laudick Pool Contractor


330' Ft. from N. Line

_____ Ft. from S. Line

_____ Ft. from E. Line

990' Ft. from W. Line

NE NW NW

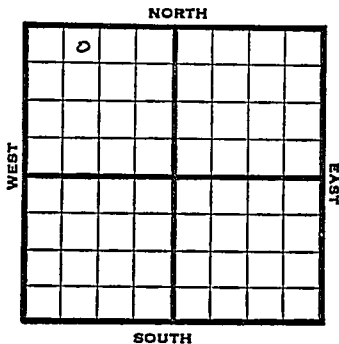

1950.

Elev. 1904' REPORT

12/27

Cellar & Pits

1951

1/17

D&A TD 3406

8" @ 273 Lans. 3129

DST 3135-47 opn 15 min

Rec. 4' mud DST 3252-71

opn 15 min. Rec. 8' mud

Cong. 3374-3406 D&A

ABANDONED

County Barton State Kansas

Sec. 32 (Blk. 16 (Sur. 12W (Twp. 16 (Rge. 12W Map No.

Operator Petroleum Inc.

Well No. 1 Farm Charles

Elev. _____ Location NE NW NW

0							

330 Ft. From N Line NW

990 Ft. From W Line Quarter

Ist. Report DEC 27 1950

Completion _____

Remarks _____

Spudding Date _____

Drig. Data Laydiok Pool

Cellar & pits

County Barton State Kansas

Sec. 32 (^{Blk.}_{Twp.}) 16 (^{Sur.}_{Rge.}) 12W Map No.

Operator Petroleum Inc.

Well No. 1 Farm Charles

Elev. 1904 Location NE NW NW

0					

330 Ft. From N Line NW

990 Ft. From W Line Quarter

Ist. Report

Completion JAN 17 1951

Remarks Laudick Pool

Spudding Date

Drlg. Data D & A TD 3406

8" @ 273 Lans. 3129 DST 3135-47

open 15 min. Rec. 4 1/2 mud DST 3252-71

open 15 min. Rec. 8' mud Cong. 3374-3406

D & A

J. E. TYRA