

Russell


KANSAS

Section.....8.....Township.....15.....Range.....13-W

Well Number.....3 Dietrick.....

**O.W.D.D**

Company.....Carter.....

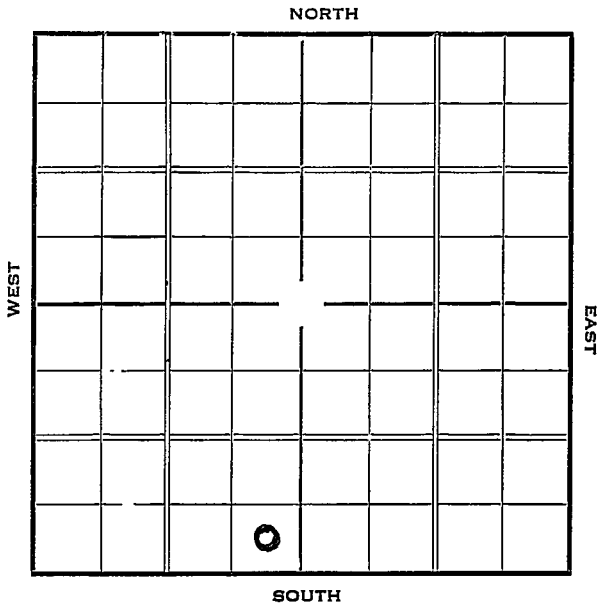

Sec. 8 Twp. 15 R. 13-W

Well No. #3 Dietrich **O.W.D.D** Farm  
Carter Company

Trapp Pool

         Ft. from N. Line


330 Ft. from S. Line

330 Ft. from E. Line

         Ft. from W. Line

SE SE SW

Elev. 1747

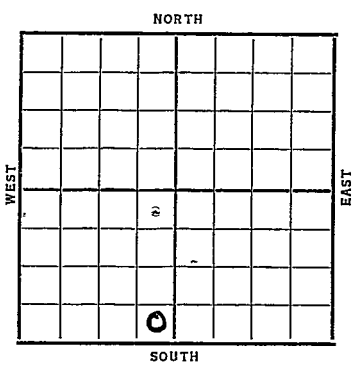

Date	REPORT
1937	
4/14	Rig
4/23	12" @ 412'. WOC.
	Drlg. 450'.
4/30	Drlg. 1875'.
5/7	SD 2725'.
5/14	" "
5/21	Topeka 2610'. K.C. 2902'.
	Pay 2931-48'. Cong. 3172'.
	Drlg. 3179'.
5/28	Sil. 3180-93'. 7" @ 3181'.
6/4	T.D. 3193'.
	1500 acid & 2000 acid.
	Averaging 40 bbls. per hr.
	on pump.
	<b>O.W.D.D</b>
	<b>OVE</b>
	<b>OVER</b>

1953

2/19 TD 3756' PB 3530 5" @ 3134-3530  
liner.

1937

6/9 7" @ 3181'.  
Sil. 3180'.  
T.D. 3193'.  
1500 A  
2000 A  
Pumped 683 bbls. 12 hrs.  
Potential 1331 bbls.

### COMPLETED

### O.W.D.D

1/14 KC 2902 Cong. 3172 Arb 3180 OTD 3193  
7" @ 3181 DD 3315

1/22 DD 3390'

1/29 Fishing @ 3417'

2/5 Drlg. 3525'

2/12 Reagan 3530'  
Drlg. 3560'

2/26 CO 3756'

3/12 TD 3853'

3/19 NR

3/26 60/3397-3412, 40/3436-46

4/1 SWD Well  
TD 3853  
KC 2902, Cong 3172, Arb 3180,  
OTD 3193  
7" @ 3181  
DD 3315 DD 3390 DD 3417  
Regan 3530  
TD 3756 PB 3530  
5" @ 3134 CO to 3756  
DD 3853 1500 A 60/ 3397-3412 40/  
3436-46 Granite 3853 4000A  
Comp. for SWD well.

### ABANDONED

**KANSAS** *Russell*Map No. \_\_\_\_\_ Sec. 8 Twp. 15 R. 13WWell No. 3 DietrichCarter Company

Contractor

**SECTION PLAT**


\_\_\_\_\_ Ft. from N. Line

380 Ft. from S. Line380 Ft. from E. Line

\_\_\_\_\_ Ft. from W. Line

**FIRST REPORT**

Location \_\_\_\_\_

Rig up \_\_\_\_\_

Drilling and Remarks:

*Rig***RECORD**

Cased \_\_\_\_\_ in., \_\_\_\_\_ ft.

Sand \_\_\_\_\_

Gas \_\_\_\_\_

Oil \_\_\_\_\_

Total Depth \_\_\_\_\_

**PRODUCTION**

1st 24 hrs. Nat. \_\_\_\_\_

1st 24 hrs. after shot \_\_\_\_\_

Gas \_\_\_\_\_ Cu. Ft.

Dry Hole \_\_\_\_\_

Abandoned \_\_\_\_\_

Date

APR 14 1957

19

S. J. LEWIS

Scout

Russell KANSAS

Map No. 73 Sec. 8 Twp. 15 R 13 W

Well No. 3 - Dietrich

Carter Company

Contractor

COMPLETED

SECTION PLAT

\_\_\_\_\_ Ft. from N. Line

330 Ft. from S. Line

330 Ft. from E. Line

\_\_\_\_\_ Ft. from W. Line

		0	

Location \_\_\_\_\_

Rig up \_\_\_\_\_

Drilling and Remarks:

1500 A

2000 A  
pumped 683/12 4/13

pat

1331

RECORD

Cased 7 in., 3181 ft.

Sand 511 - 3180

Gas \_\_\_\_\_

Oil \_\_\_\_\_

Total Depth 3193

PRODUCTION

1st 24 hrs. Nat. \_\_\_\_\_

1st 24 hrs. after shot \_\_\_\_\_

Gas \_\_\_\_\_ Cu. Ft.

Dry Hole \_\_\_\_\_

Abandoned \_\_\_\_\_

Date

JUN 9 1937 19

H. D. Hatfield

Scout



