

KANSAS

Russell

Section 5 Township 12 Range 15W

Well No. 13 Kohlman

Company T C Johnson Est.

Fairport

NORTH

			6				

WEST

EAST

SOUTH

KANSAS Russell

Sec. 5 Twp. 12 R. 15W ✓

Well No. #13 Kohlman Farm

T. C. Johnson Est. Company


Fairport (Pickrell Drlg., Cont.) **NORTH**

Pool
330' Ft. from N. Line

_____ Ft. from S. Line

390' Ft. from E. Line

_____ Ft. from W. Line

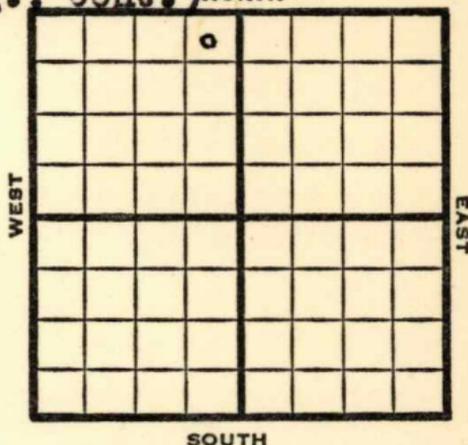

NE NW

1949

Elev 1733' REPORT

5/18

8" @ 773'
Drlg. 1715'

5/25

Lans. 2833'
Sooy 3137'
TD 3140
5" @ 3137'

6/1

"

6/7

"

6/15

"

6/21

160' oil 2hrs.

6/28

"

7/6

"

7/12

"

7/20

"

7/27

"

8/3

"

8/10

"

8/17

"

8/24

TD 3141'
Sooy 3137'
5" @ 3137'
Pump 25 Oil / 60W Pot
38° Gr
Comp

COMPLETED

Map No. _____ Sec. 5 Twp. 12 R. 15W

Well No. 13 Kohlman

T. C. Johnson Est. Company

Pickrell Drlg. Contractor

NE NW

FIRST REPORT
SECTION PLAT

330 Ft. from N. Line

_____ Ft. from S. Line

390 Ft. from E. Line

_____ Ft. from W. Line

		o	

Russell County

Location _____

Rig up _____

Drilling and Remarks:

8" @ 773

drlg. 1715

RECORD

Cased _____ in., _____ ft.

Sand _____

Gas _____

Oil _____

Total Depth _____

PRODUCTION

1st 24 hrs. Nat. _____

1st 24 hrs. after shot _____

Gas _____ Cu. Ft.

Dry Hole _____

Abandoned _____

Date

MAY 18 1949 19

S. J. LEWIS Scout

Map No. K 72 Sec. 5 Twp. 12 R. 15W

Well No. 13 Kohlman

T. C. Johnson Est. Company

COMPLETE Contractor

NE NW

E1,1733
SECTION PLAT

330 Ft. from N. Line

_____ Ft. from S. Line

390 Ft. from E. Line

_____ Ft. from W. Line

	o		

Russell County

RECORD

Location _____

Cased _____ in., _____ ft.

Rig up _____

Sand _____

Drilling and Remarks:

Gas _____

Oil _____

Total Depth 3141

PRODUCTION

1st 24 hrs. Nat. _____

1st 24 hrs. after shot _____

Gas _____ Cu. Ft.

Dry Hole _____

Abandoned _____

Date

AUG 24 1949 19

S. J. LEWIS

Scout

Sony 3137
SW @ 3137
Prod 25 oil + 60W
P-X
38-64

Placed Map
Misc. 321M