


Section 32 Township 16 Range 12WWell No. #1 SchneweisCompany J. Bergman Oil

NORTH

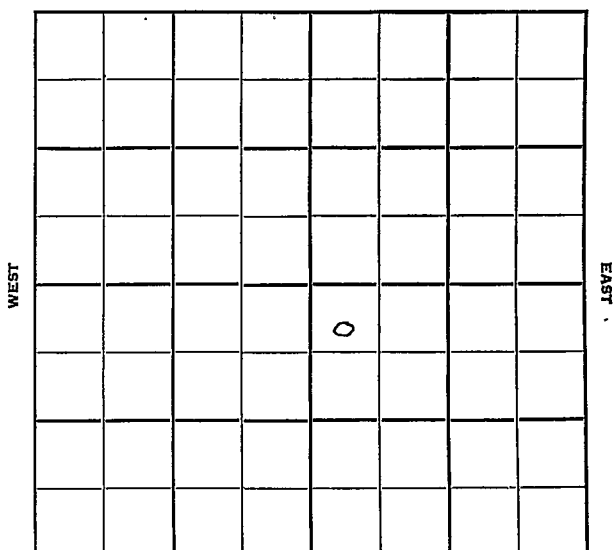

SOUTH

Barton

32

16

KANSAS 12W

Sec. Twp. R.

Well No. #1 Schneweis Farm

J. Bergman Oil Company

Honaker Drlg. - Contr. Contractor

Laudick Pool


330' Ft. from N. Line

Ft. from S. Line

Ft. from E. Line

330' Ft. from W. Line

NW NW SE

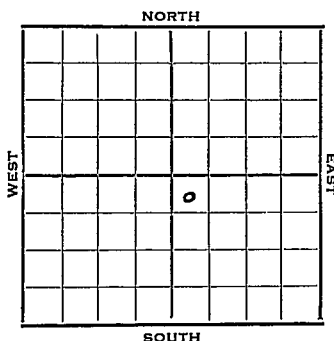

1951 Elev. 1922' REPORT

12/12 Spud 12-10-51
8-5/8" @ 159'
WOC

1952
1/2 Spud 12-10-51
D&A TD 3418
8-5/8" @ 159
Anhy 820 Br. Li 3122
Ians. 3141 Cong. 3388
Arb. 3397-3418 TD
D&A

ABANDONED

County **Barton** State **Kansas**

Sec. 32 (Blk. Twp.) 16 (Sur. Rge.) 12W Map No.

Operator J. Bergman Oil

Well No. 1 Farm Schneweis

Elev.	Location	NW	NW	SE

FIRST REPORT

330 Ft. From N Line SE

330 Ft. From W Line Quarter

1st. Report **DEC 1 2 1951**

Completion

Remarks


Honaker Drig. - Contr.

Spudding Date **12-10-51**

Drlg. Data Laudick Pool

8 5/8" @ 159 WOC

J. E. TYRA

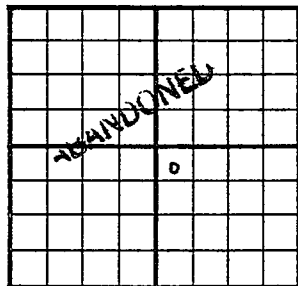County Barton State KansasSec. 32 (Blk.
Twp.) 16 (Sur.
Rge.) 12W Map No.Operator J. Bergman OilWell No. 1 Farm SchmeweisElev. 1922 Location NW NW SE330 Ft. From N Line SE330 Ft. From W Line Quarter1st. ReportCompletion JAN 2 1952Remarks Laudick PoolHonaker Drlg. - Contr.Spudding Date 12-10-51Drlg. Data D & A TD 34188 5/8" @ 159 Anhy 820 Br. lime 3122Lans. 3141 Cong. 3388 Arb. 3397-3418 TDD & A

J. E. TYRA