


Russell

KANSAS

Section 8 Township 15 Range 13-W

Well Number 4 Dietrick


Company Carter

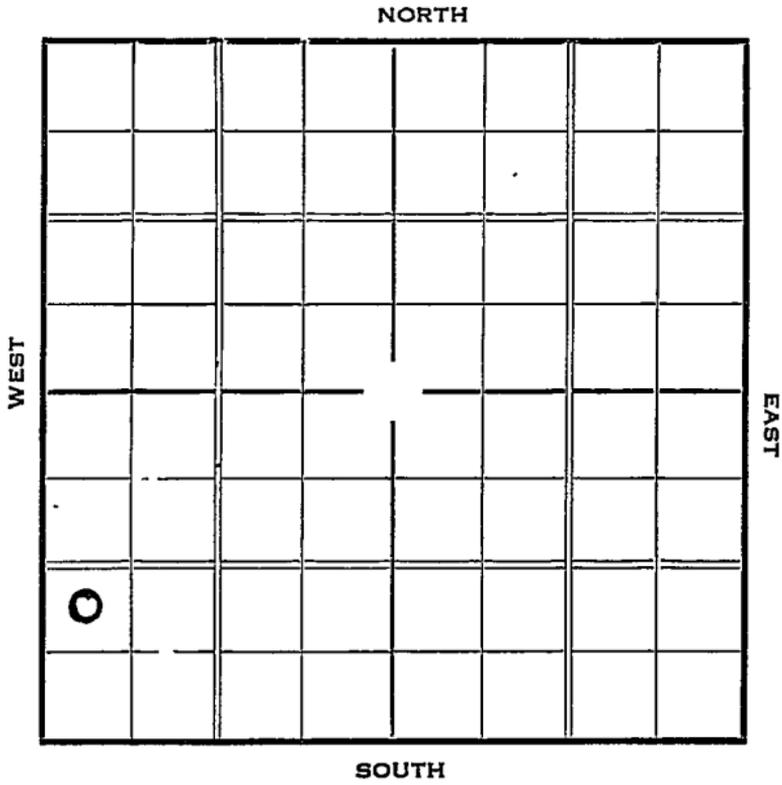

Sec. 8 Twp. 15 R. 13-W

Well No. #4 Dietrich Farm
Carter Company

_____ Ft. from N. Line
990 Ft. from S. Line
 _____ Ft. from E. Line
330 Ft. from W. Line
 Elev. 1759

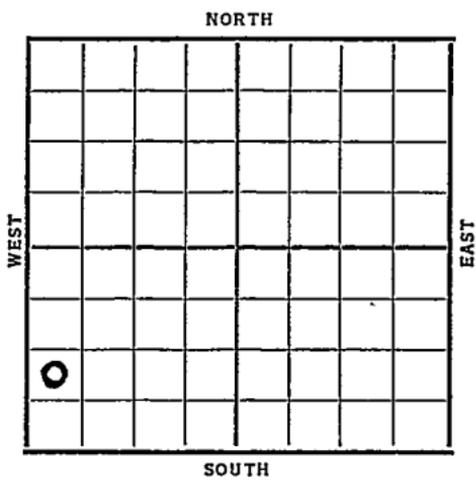

Date	REPORT
1937	
4/14	Location
4/23	12" @ 407'. Drlg. 415'. WOC.
4/30	Drlg. 2000'.
5/7	Topeka 2610'.
	S. Oil 2776-2778'.
	S.O. 2866-68'.
	K.C. 2913'. Sat. core 2951-
	2961'. Drlg. 2975'.
5/13	Sil. 3183'. 7" @ 3183'.
	T.D. 3188'. WOC.
5/19	7" @ 3183'.
	Sil. 3183'.
	T.D. 3188'.
	Potential 1570 bbls.
	COMPLETED

KANSAS *Russell*

Map No. _____ Sec. 8 Twp. 15 R. 13W

Well No. 4 Dietrich

Carter Company

Contractor

SECTION PLAT

0			

_____ Ft. from N. Line

990 Ft. from S. Line

_____ Ft. from E. Line

330 Ft. from W. Line

FIRST REPORT

Location ✓

Rig up _____

Drilling and Remarks:

RECORD

Cased _____ in., _____ ft.

Sand _____

Gas _____

Oil _____

Total Depth _____

PRODUCTION

1st 24 hrs. Nat. _____

1st 24 hrs. after shot _____

Gas _____ Cu. Ft.

Dry Hole _____

Abandoned _____

Date 14 1937

Russell KANSAS

Map No. 73 Sec. 8 Twp. 15 R. 13^WWell No. 4 - DietrichCarter Company

Contractor

COMPLETED**SECTION PLAT**

0			

_____ Ft. from N. Line

990 Ft. from S. Line

_____ Ft. from E. Line

330 Ft. from W. Line

Location _____

Rig up _____

Drilling and Remarks:

Pot - 1570**RECORD**Cased 7 in., 3183 ft.Sand 511 3183

Gas _____

Oil _____

Total Depth 3188**PRODUCTION**

1st 24 hrs. Nat. _____

1st 24 hrs. after shot _____

Gas _____ Cu. Ft.

Dry Hole _____

Abandoned _____

Date

MAY 19 1937 19

H. D. Hatfield

Scout