
Barton KANSAS

SECTION 32 TOWNSHIP 16S RANGE 12W

WELL NO. #1 Charles

COMPANY Wilkinson Drlg.

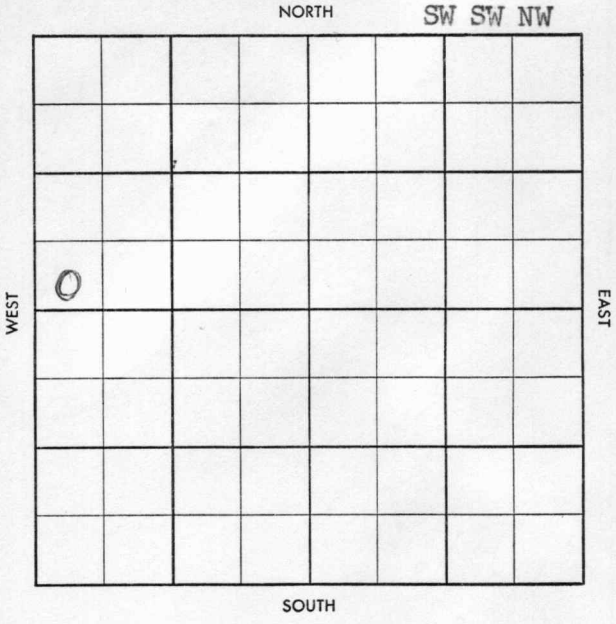

FORM 504-3 SUNRAY

S-513-B

County Barton Elev. 12W

Sec. 32 Twp. 16 Rge.

Company Wilkinson Drlg.

Farm Name Charles No. 1

TOPS	DEPTH	LOG	DATUM
Anh.			
Tp.			
H.			
Tr.			
Dg.			
B. L.			
L.			
K.C.			
B.K.C.			
Ce.			
C.			
M.			
M.			
K.			
Mz.			
Mq.			
V.			
S.			
S.			
A.			
R.			
Pf.			
G.			
T.D.			

Loc. in Sec. SW SW NW

Geol.

Contr. Co. Tools #1

Pool Reif So.



Date Comm.

Location ETD 3400'

Our map room shows Twp. 16-Rge. 12W in Barton County. Please check Sec., Twp., Rge. and County and advise.

Thanks,

Sam Baird

DATUM	LOG	DEPTH	TOPS
			Anh.
			To.
			H.
			Tr.
			Dg.
			B. L.
			L.
			K.C.
			B.K.C.
			Ce.
			C.
			M.
			M.
			K.
			Mz.
			Mq.
			V.
			S.
			S.
			A.
			R.
			Pt.
			G.
			T.D.



Twp. Pool

Co. Facet

S-513-B

County Barton Elev. 1913DF 1916RB

Sec. 32 Twp. 16 Rge. 12W

Company Wilkinson Drlg.

Farm Name Charles No. 1

TOPS	DEPTH	LOG	DATUM
Anh.			
Tp.			
H.	3034		
Tr.			
Dg.	3061		
B.L.			
L.	3135		
K.C.			
B.K.C.			
Ce.			
C.	3361		
M.			
M.			
K.			
Mz.			
Mq.			
V.			
S.			
S.			
A.	3418		
R.			
Pf.			
G.			
T.D.	3441		

Loc. in Sec. SW SW NW

Geol.

Contr. Co. Tools #1

Pool Reif So.

MAY 28 '58

ABANDONED

Date Comm. 5-8-58 8"293/180

Location ETD 3400' MAY 7 '58 MAY 14 '58 Ø MAY 21 '58

DST 3138-70. op 90" 30'SOCMW BHP0 DST 3154-3211 op 60" 39'OM BHP170 DST 3274-3321 60" 10'M BHP50

D&A (HWd)

Co. Lse. No. Sec. T. R.