

KANSAS


Russell

Form 51-5M-7-40-Palace

Section 8 Township 15 Range 13-W

Well No. #1 Rein

Company Irwin Drilling et al

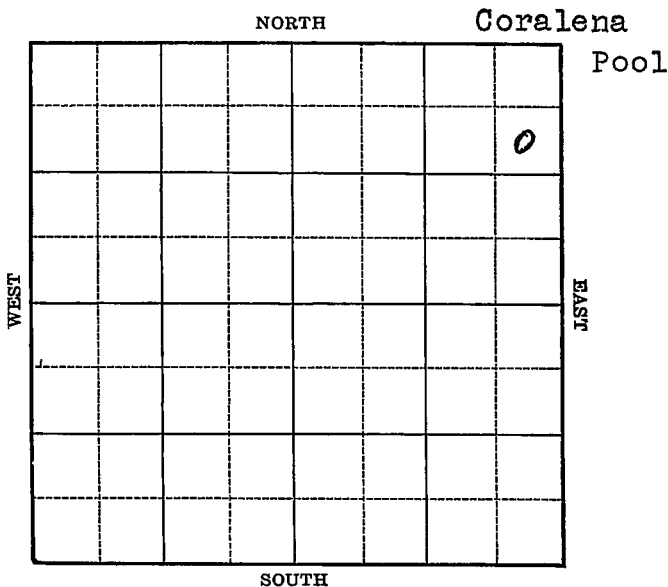

Sec. 8 Twp. 15 R. 13-W

Well No. #1 Rein Farm

Irwin Drilling et al Company

(Coralena)


990 Ft. from N. Line

_____ Ft. from S. Line

330 Ft. from E. Line

_____ Ft. from W. Line

Elev. 1869

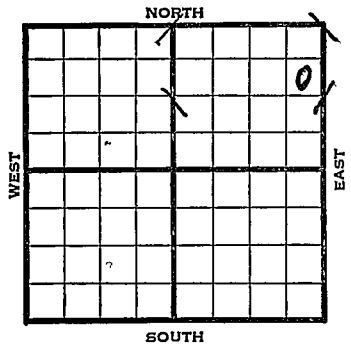

1940	REPORT
11/20	Cellar.
11/27	Rigging up cable.
12/5	" " "
12/12	12" - 476' Anhy 822'
	10" - 826' Drlg. 1370'
12/19	Drlg. 2150'
12/26	8" - 2365' SD.
1941	
1/2	" " "
1/9	" " "
1/16	" " "
1/23	" " "
1/30	" " "
2/6	" " "
2/13	Topeka 2730' Drlg. 2815'
2/20	Dodge 2986' Lans. ^{3039'} 3029-42' T.D.
	U.R. 7".
2/27	Lans. 3039' (Corrected)
	8" - 3040' T.D. 3138' 800'
	oil 16 hours.
	Drlg. 3265'

OVER

1941		3309	
3/6	Arb.	3312 21'	T.D. 1900' oil.
	5"	3313 310'	WOC.
3/13	Arb.	3309'	(Corrected)
	5"	3310'	T.D. 3318'
			1000 acid.
3/20	"	"	"
3/27	T.D.	3330'	Swab 25 bbls. oil a day. Shut down.
4/2	"	"	"
4/10	"	"	"
4/16	Arbuckle	3309'	
	T.D.	3330'	
		2500 acid.	
		15 bbls.	
		38.2 Gravity	

COMPLETED

Map No. 73 Sec. 8 Twp. 15 R. 13W

Well No. 1 Rein

Irwin Drilling 'etal Company

Contractor

FIRST REPORT

SECTION PLAT

SE NE NE

990 Ft. from N. Line

_____ Ft. from S. Line

330 Ft. from E. Line

_____ Ft. from W. Line

CORALENA POOL

Location _____

Rig up _____

Drilling and Remarks:

Cellar

RECORD

Cased _____ in., _____ ft.

Sand _____

Gas _____

Oil _____

Total Depth _____

PRODUCTION

1st 24 hrs. Nat. _____

1st 24 hrs. after shot _____

Gas _____ Cu. Ft.

Dry Hole _____

Abandoned _____

Date

NOV 20 1940 19

S. J. LEWIS Scout

Map No. 73 Sec. 8 Twp. 15 R. 13WWell No. 1 ReinIrwin Drilling etal Company

Contractor

COMPLETED

SE NE NE

990 Ft. from N. Line

Ft. from S. Line

330 Ft. from E. Line

Ft. from W. Line

CORALENA POOL

SECTION PLAT

			o

Location _____

Rig up _____

Drilling and Remarks:

2500 acid15 Pkts38.2 Grav.**RECORD**

Cased _____ in. _____ ft.

Sand Subsack 3309

Gas _____

Oil _____

Total Depth 3330**PRODUCTION**

1st 24 hrs. Nat. _____

1st 24 hrs. after shot _____

Gas _____ Cu. Ft.

Dry Hole _____

Abandoned _____

Date

APR 16 1941 19

S. J. LEWIS

Scout