


Section 7 Township 12 Range 15W

Well No. #1 Oswald

Company Nadel & Gussman

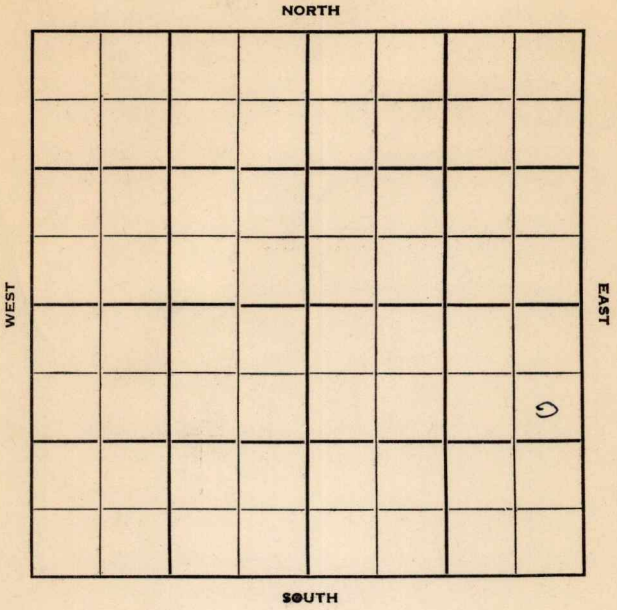

Sec. 7 Twp. 12 R. 15 W

Well No. # 1 Oswald Farm

Nadel & Gussman Company

Contractor


990 Fairport Pool
Ft. from N. Line

Ft. from S. Line

330 Ft. from E. Line

Ft. from W. Line

SE NE SE

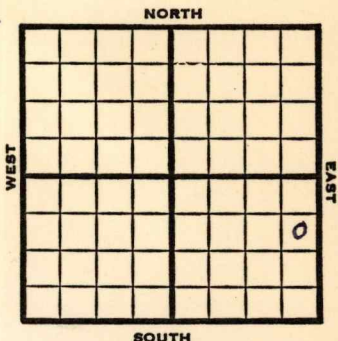

1951 Elev. 1821' REPORT

3/21 Location

4/4 Spud 3-14-51
 D & A TD 3360'
 8" @ 295 Anhy 899' Top 2160'
 Heeb 2931' Toronto 2950' Lans 2983'
 Cong. 3296'
 TD 3360' D & A

ABANDONED

County Russell State Kansas

Sec. 7 (Blk. (Twp.)) 12 (Sur. (Rge.)) 15W Map No.

Operator Nadel & Gussman

Well No. 1 Farm Oswald

Elev. 1821 Location SE NE SE

990 Ft. From N Line SE
330 Ft. From E Line Quarter

Ist. Report _____

Completion APR 4 1951

Remarks Fairport Pool

Spudding Date 3-14-51

Drig. Data D & A TD 3360

8" @ 295 Anhy 899 Top. 2160

Heeb. 2931 Toronto 2950 Lans. 2983

Cong. 3296 TD 3360

D & A