


Section 33 Township 16 Range 12W

Well No. #1 Prosser

Company Brooks-Pierce

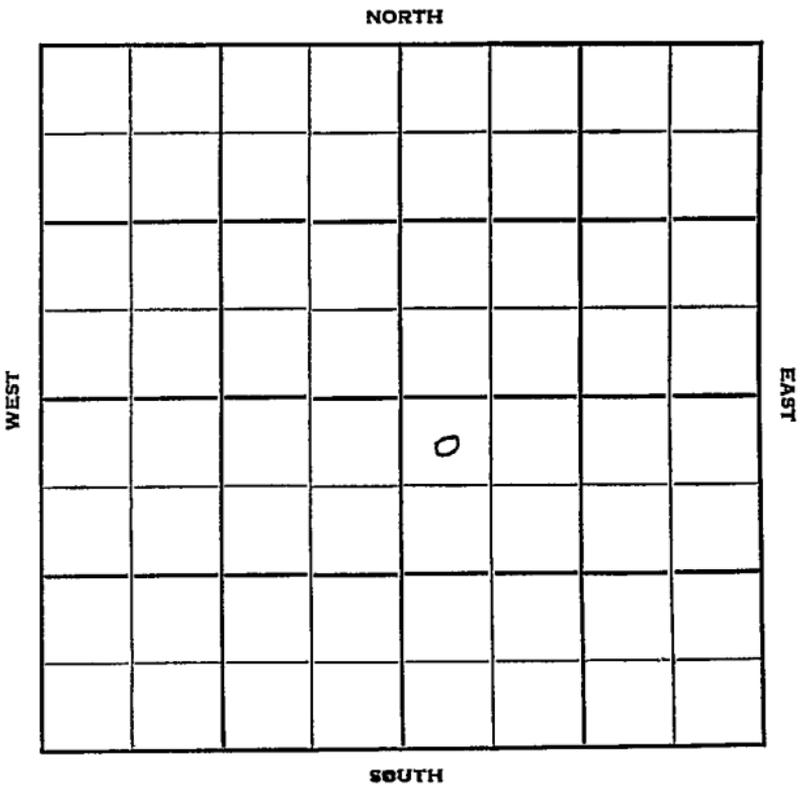

Barton
16

KANSAS
12W

Sec. 33 Twp. _____ R. _____

Well No. #1 Prosser Farm _____

ⁿBrooks -Pierce Company _____

Brooks-Pierce - Contr. Contractor _____

Laudick Pool


330' Ft. from N. Line

_____ Ft. from S. Line

_____ Ft. from E. Line

330' Ft. from W. Line

NW NW SE

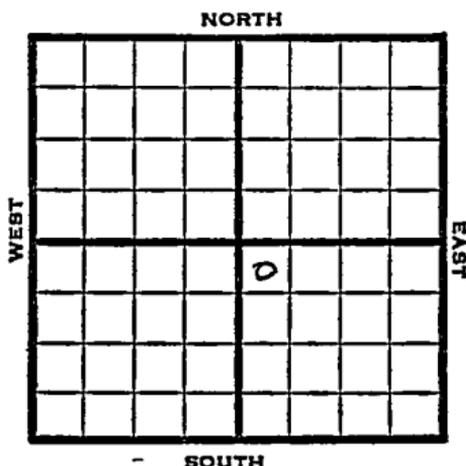

1951

Elev. 1873' REPORT

2/6 Drlg.

2/28

Spud 1-31-51
 D&A TD 3347
 8" @ 205
 Heeb. 2979 Lans. 3081
 Arb. 3337
 DST 3339-47 opn 1 hr.
 Rec. 80' oil 10' mud
 5" @ 3339 TD 3347
 20 goph 500 A S/18 bwph SSO
 D&A

ABANDONED

County Barton State Kansas

Sec. 33 (Blk. 16) (Sur. 12W) (Twp.) (Rge.) Map No.

Operator Brooks - Pierce

Well No. 1 Farm Prosser

Elev. 1873 Location NW NW SE

330 Ft. From N Line SE

330 Ft. From W Line Quarter

1st. Report

Completion FEB 28 1951

Remarks Laudick Pool

Brooks - Pierce - Contr.

Spudding Date 1-31-51

Drig. Data D & A TD 3347

8" @ 205 Heeb. 2979 Lans. 3081

Arb. 3337 DST 3339-47 open 1 hr.

Rec. 80' oil 10' mud 5" @ 3339 TD 3347

20 goph 500A S/ 18 bwph SSO

D & A