


Section 8 Township 15 Range 13-W

Well No. #11 Detrich

Company Carter Oil

Coralena Pool

NORTH

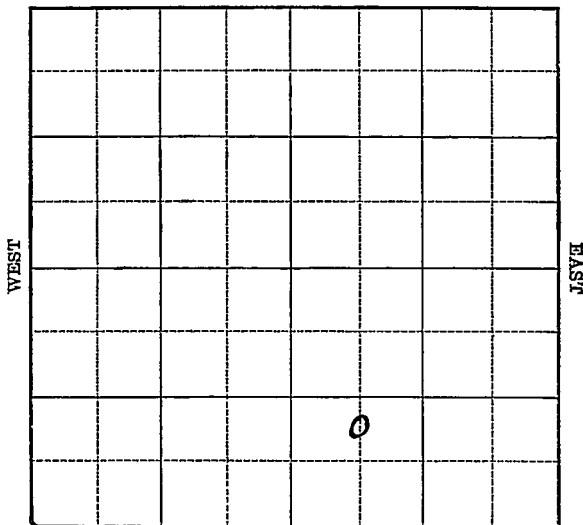

SOUTH

Sec. 8 Twp. 15 R. 13-W

Well No. #11 Detrich O.W.W.O. Farm

Carter Oil Company

(Coralena)


_____ Ft. from N. Line

990 Ft. from S. Line

_____ Ft. from E. Line

660 Ft. from W. Line

Elev. 1772

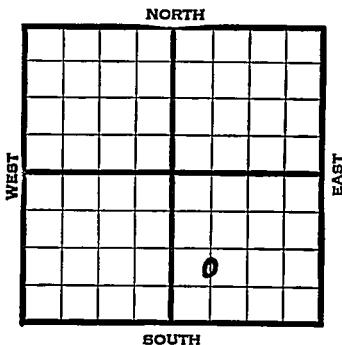

1940	REPORT
5/8	Location
5/16	"
5/23	"
5/29	"
6/6	8" - 235' Drlg. 1160'
6/13	Fsg. 1890'
6/20	Topeka 2640' Dodge 2885'
	SSO 2885-2900' Lans. 2930'
	SO 2951-53' SO 2966-67'
	Drlg. 3035'
6/27	Arb. 3221' 5" - 3221'
	T.D. 3225' RUST.
7/3	P.B. to 3190' Ripped csg.
	3000 acid. Swab 28 bbls. per hr
	500 acid. W.O.A.
	OVER

1940

7/10

Lans. 2930'
Arb. 3221'
5" - 3221'
T.D. 3225'
P.B. to 3190'
Ripped csg. 3162-74'
8000 acid.
Potential 772 bbls., pump.

COMPLETED

1954

O.W.W.O.

5/26

Oil Well
TD 3225'
Top 2640', Dodge 2885', KC 2930'
Arb 3205'
OTD 3225'
5" @ 3221'
PB 3215'
12/ 3207-09 100 A P/ 75 bopd.
Comp.

FIRST REPORT

COMPLETED

Map No. 73 Sec. 8 Twp. 15 R. 13WWell No. 11 DetrichCarter Oil

Company

Contractor

FIRST REPORT

C N L SW SE

 Ft. from N. Line990 Ft. from S. Line Ft. from E. Line660 Ft. from W. Line

CORALENA POOL

SECTION PLAT

		o	

Location XRig up

Drilling and Remarks:

RECORD

Cased in., ft.Sand Gas Oil Total Depth

PRODUCTION

1st 24 hrs. Nat. 1st 24 hrs. after shot Gas Cu. Ft.Dry Hole Abandoned

Date

MAY 8 1940 19S. J. LEWIS

Scout

Map No. _____ Sec. 8 Twp. 15 R. 13W

Well No. 11 Detrich

Carter Oil _____ Company

Contractor

COMPLETED

SECTION PLAT

C N L SW SE

_____ Ft. from N. Line

990 Ft. from S. Line

_____ Ft. from E. Line

660 Ft. from W. Line

		o	

CORALENA POOL

Location _____

Rig up _____

Drilling and Remarks:

4 ans 2930
 Cr 83221
 5" C 3221
 P.B 3190
 Ripped csg 3162-74
 8000 a bid
 Pump 772 P.X.

RECORD

Cased _____ in., _____ ft.

Sand _____

Gas _____

Oil _____

Total Depth 3225

PRODUCTION

1st 24 hrs. Nat. _____

1st 24 hrs. after shot _____

Gas _____ Cu. Ft.

Dry Hole _____

Abandoned _____

Date

JUL 10 1940 19

S. J. LEWIS Scout

