

KANSAS

Form 51-5M-7-39-Palace

O.W.W.O.

Russell

KANSAS

Section 8 Township 15 S Range 13 W

Well No. #10 Detrich


Company Carter Oil Co.

N/2 SE SE

NORTH Coralena Pool

WEST

EAST

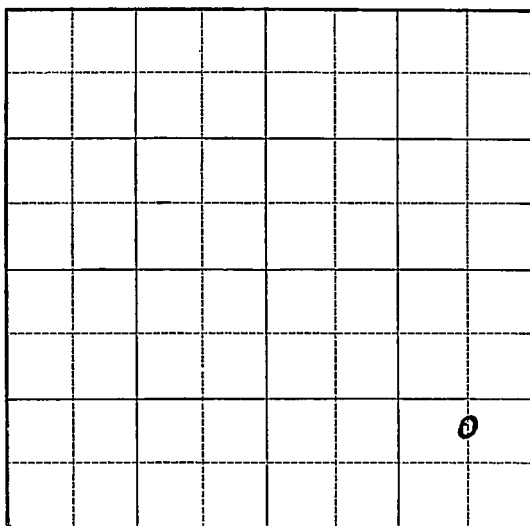

SOUTH

O.W.W.O. KANSAS


Russell

Sec. 8 Twp. 15 S R. 13-WWell No. #10 Detrich FarmCarter Oil
Carter Oil Company

(Coralena)

 Ft. from N. Line990 Ft. from S. Line660 Ft. from E. Line Ft. from W. LineN/2 SE SE

Elev. 1805

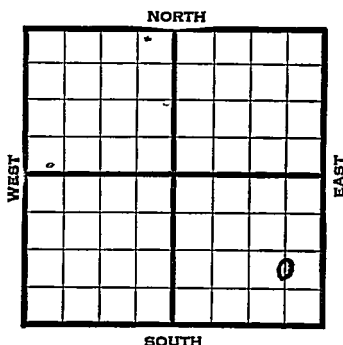

1940	REPORT
5/8	Location
5/16	Rotary.
5/23	8" - 250' Drlg. 1674'
5/29	Lans. 2979' S.G. 2999-3001'
	Drlg. 3041'
6/6	Arb. 3256' T.D. 3259'
	5" - 3257' RUST.
6/13	Ripped pipe 29 96-98 and 30 09-17
	8000 acid. Swab 5 bbls. per hr.
	12 hours.
6/20	" " "
6/27	" " "
7/3	" " "
7/11	Swab 28 bbls. 3 hours.
7/18	" " " "
	OVER

1940
7/24

Arb. 3256'

Lans. 2979'

5" - 3257'

T.D. 3259'

Ripped pipe 2996-98 & 3009-17'

9000 acid.

Potential 173 bbls., pump.

COMPLETED

Map No. 73 Sec. 8 Twp. 15 R. 13WWell No. 10 DetrichCarter Oil CompanyContractor

FIRST REPORT

C N L SE SE

 Ft. from N. Line990 Ft. from S. Line660 Ft. from E. Line Ft. from W. Line

CORALENA POOL

SECTION PLAT

			o

Location XRig up

Drilling and Remarks:

RECORD

Cased in., ft.Sand Gas Oil Total Depth

PRODUCTION

1st 24 hrs. Nat. 1st 24 hrs. after shot Gas Cu. Ft.Dry Hole Abandoned

Date

MAY 8 1940₁₉S. J. LEWIS Scout

Map No. 73 Sec. 8 Twp. 15 R. 13WWell No. 10 DetrichCarter Oil

Company

Contractor

COMPLETED
C N L SE SE**SECTION PLAT**

			o

 Ft. from N. Line990 Ft. from S. Line660 Ft. from E. Line Ft. from W. Line

CORALENA POOL

Location Rig up

Drilling and Remarks:

*Re 8.3256. Lams 2979**5" @ 3257**Ripped Pipe 2996-9**8-3009-17**9000 acid**Pump 173 28***RECORD**Cased in., ft.Sand Gas Oil Total Depth 8259**PRODUCTION**1st. 24 hrs. Nat. 1st 24 hrs. after shot Gas Cu. Ft.Dry Hole Abandoned

Date

III 24 1940 19S. J. LEWIS Scout

O.W.W.O.

FORM 513 SUNRAY

County Russell Elev. 1805 DF
 Sec. 8 Twp. 15 Rge. 13W
 Company The Carter Oil Co.
 Farm Name J. Dietrich No. 10

TOPS	DEPTH	LOG	DATUM	Loc. in Sec.
Anh.				C N/2 SE SE
Tp.				(OWWO)
H.				Geol.
Tr.				Contr.
Dg.				Pool
Bl.				Trapp
L.	2979			FIRST REPORT
K.C.				
B.K.C.				
Ce.				
C.				
M.				
M.				
K.				
Mz.				
Mo.				
V.				
S.				
S.				
A	3253-65			
R.				
PC.				
G.				
T.D.	otd	3256		

Date Comm. 5" @ 3251/175, perf 2996-98 & 3009-17
was Lans prod.
New Info - to CO to Arb. CO 3250 - Sqz
Lans perfs 2996-98 & 3009-17, CO DD 3259 TD
to acidize

13

FORM 513 SUNRAY

County Russell Elev. 1805 DF
 Sec. 8 Twp. 15 Rge. 13W
 Company The Carter Oil Co.
 FarmName J. Dietrich No. 10

TOPS	DEPTH	LOG	DATUM	Loc. in Sec.
Anh.				C N/2 SE SE
TP.				(OWWO)
H.				
Tr.				
Dg.				
Bl.				
L.	2979			Geol.
K.C.				Contr.
B.K.C.				
Ce.				
C.				
M.				Pool
M.				Trapp
K.				
Mz.				
Ma.				
V.				
S.				
S.				
A.	3253-65			COMPLETE
R.				
PE.				
G.				
TD.	otd	3256		SEP 18 '57

Date Comm. 5" @ 3254/175, perf 2996-98 & 3009-17
 was Lans prod.

New Info - to CO to Arb. CO 3250 - Sqz
 Lans perfs 2996-98 & 3009-17, CO DD 3259 TD
 to acidize SEP 4 '57 SEP 11 '57 SEP 18 '57

1500 acid \$ 6 BOPH new
 nothing 80 BOPD in wtr 5' open
 Hole