
DX 78-1

Barton KANSAS

Section 33 Township 16 Range 12 W

Well No. # 1 Schneweis

Company B & R Drlg.

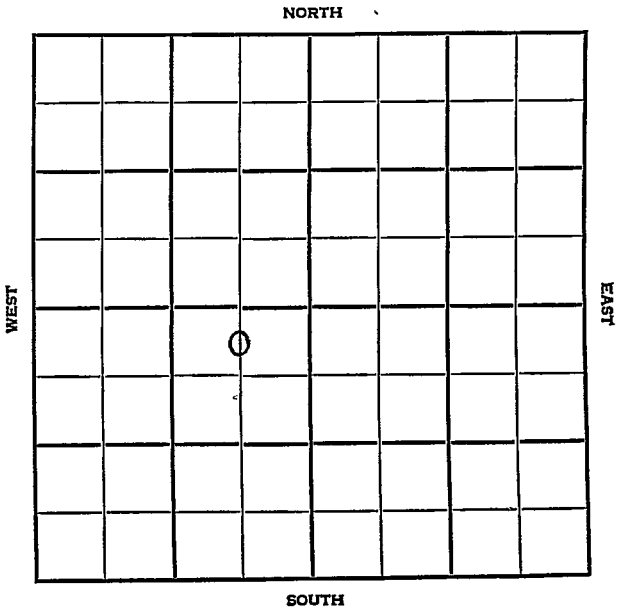

Barton KANSAS

SEC	TWP	R.
33	16	12W

WELL NO

1 Schneweis FARM

COMPANY

B&R Drlg.

CONTRACTOR

Co. Tools


Beaver Ext.

330 Ft. from N. Line

Ft. from S. Line

660 Ft. from E. Line

Ft. from W. Line

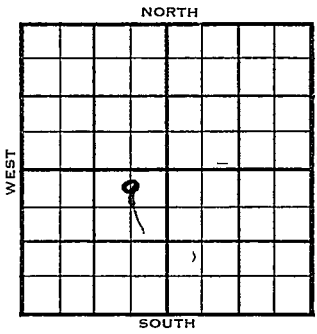

C N/2 NE SW

1954	ELEVATION 1870'	REPORT
8/18		Spud 8-12-54 8" @ 263' Drlg. 2640'
9/1		Spud 8-12-54 D & A TD 3370 8" @ 263 Heeb 2975 Tor. 2992 Doug 3004 Br. lime 3065 Lans 3082 DST 3069-3103 open ½ hr rec 12' mud Arb. 3339 DST 3344-50 open 1 hr rec 60' clean oi 100' muddy oil 500# TD 3370 KM 5" @ 3370 Perf/3343-45 100 A HFW D & A ABANDONED

DX-78

FORM 275 FOR SALE BY KANSAS BLUE PRINT CO.


County Barton State Kansas

Sec. 33 (Blk. Twp.) 16 (Sur. Rge.) 12W Map No.

Operator B & R Drlg.

Well No. 1 Farm Schneweis

Elev. Location C N½ NE SW

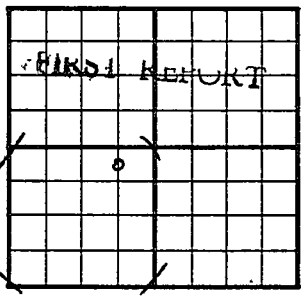

330 Ft. From N Line SW

660 Ft. From E Line Quarter

1st. Report AUG 18 1954

Completion

Remarks Co. tools

Spudding Date 8-12-54

Drlg. Data Beaver Ext.

8" @ 263 drlg. 2640

FABEN GILSTRAP

FORM 275 FOR SALE BY KANSAS BLUE PRINT CO.


County Barton State Kansas

Sec. 33 (Blk. Twp.) 16 (Sur. Rge.) 12W Map No.

Operator B & R Drlg.

Well No. 1 Farm Schneweis

Elev. 1870 Location C N½ NE SW

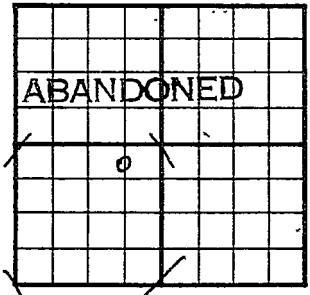

330 Ft. From N Line SW

660 Ft. From E Line Quarter

1st. Report

Completion SEP 1 1954

Remarks Beaver Ext. Co. tools

Spudding Date 8-12-54

Drlg. Data D & A TD 3370

8" @ 263 Heeb. 2975 Tor. 2992

Doug. 3004 Br. lime 3065 Lans. 3082

DST 3069-3103 open ½ hr. Rec. 12' mud

Arb. 3339 DST 3344-50 open 1 hr. Rec.

60' clean oil 100' muddy oil 500 #

TD 3370 5" @ 3370 perf/ 3343-45 100 A

HFW

D & A

FABEN GILSTRAP