
Barton KANSAS

SECTION 33 TOWNSHIP 16 RANGE 12W

WELL NO. #1 Schneweis

COMPANY Rio Hondo Oil & Dev. Co. (New Orleans)

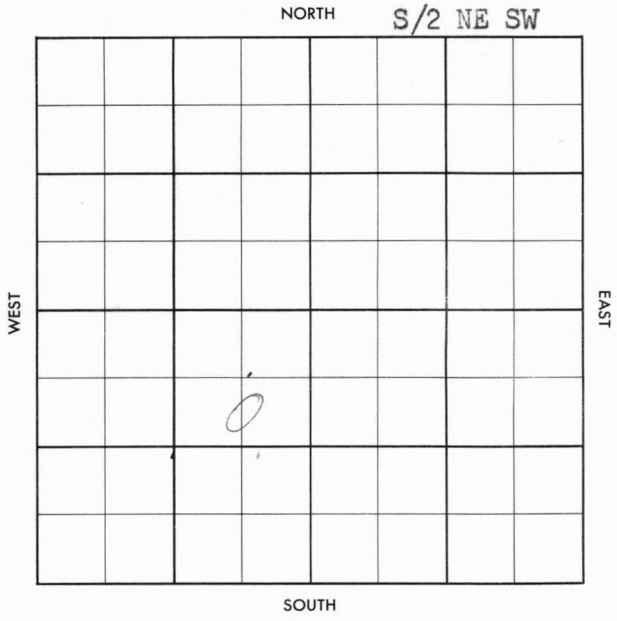


FORM 504-3 SUNRAY

FORM 513 SUNRAY

County Barton Elev.

Sec. 33 Twp. 16 Rge. 12W

Company Rio Hondo Oil & Dev. Co. (New Orleans)

Farm Name Schneweis No. 1

| TOPS | DEPTH | LOG | DATUM |
|---|---|---|---|
| Anh. | | | |
| T.P. | | | |
| H. | | | |
| Tr. | | | |
| Dg. | | | |
| B.L. | | | |
| L. | | | |
| K.C. | | | |
| B.K.C. | | | |
| Ce. | | | |
| C. | | | |
| M. | | | |
| M. | | | |
| K. | | | |
| Mz. | | | |
| Mq. | | | |
| V. | | | |
| S. | | | |
| S. | | | |
| A | | | |
| R. | | | |
| P€. | | | |
| G. | | | |
| T.D. | | | |

Loc. in Sec. S/2 NE SW

Geol. Johnson

Contr. Isern Drlg.

Pool Laudick

FIRST REPORT

APR 24 '57

Date Comm. MIRT

Co. Lse. No. Sec. T. R.

FORM 513 SUNRAY

County Barton Elev. 1678 Co.

Sec. 33 Twp. 16 Rge. 12W

Company Rio Hondo Oil & Dev. Co. (New Orleans)

Farm Name Schneweis No. 1

| TOPS | DEPTH | LOG | DATUM |
|---|---|---|---|
| Anh. | 755 | | |
| Tp. | | | |
| H. | 2978 | | |
| Tr. | | | |
| Dg. | | | |
| Bl. | 3062 | | |
| L. | - 3086 | | |
| K.C. | | | |
| B.K.C. | | | |
| Ce. | | | |
| C. Sdy | 3329 | | |
| M. | | | |
| M. | | | |
| K. | | | |
| Mz. | | | |
| Mo. | | | |
| V. | | | |
| S. | | | |
| S. | | | |
| A | 3336 | | |
| R. | | | |
| P€. | | | |
| G. | | | |
| T.D. | 3339 | | |

Loc. in Sec. S/2 NE SW

Geol. Johnson

Contr. Isern Drlg.

Lse.

Pool Hard Laudick

COMPLETE

O

JUN 5 57

No.

Date Comm. Sec.

MIRT MAY 1 57 X spd 4-22-57 85/8 @ 330/175. Hohy 755 H6 2978 Bl 3062 Lsg 3086 DST 3084-3100 gd 1hr rec 130' OCM BHP 400 ℗ 3155 MAY @ 57 DST 3123-55 1hr rec 20' SOCM BHP 0/20 DST 3239-63 1hr rec 60' GIP rec 90' MCO BHP 850/20 DST 3331-39 1hr rec 30' HO

T.

R.

FORM 513-1 SUNRAY

E & GCM 950/20" 5½ 3338/100
MAY 15 57 T & R MAY 22 57 DSP MAY 29 57
JUN 5 57 CO 3340 TD P. 25
Bond no/wtr

33-16-12W S/2 NE SW