


Section.....8.....Township.....15.....Range.....13-W

Well Number.....#6 Detrich.....

Company.....Carter.....

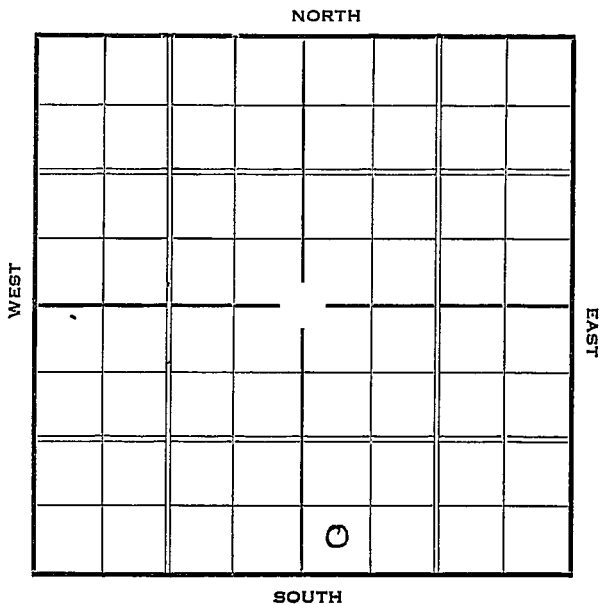

Sec. 8 Twp. 15 R. 13-W

Well No. #6 Detrich Farm

Carter Company


 Ft. from N. Line

330 Ft. from S. Line

 Ft. from E. Line

330 Ft. from W. Line

Elev. 1775

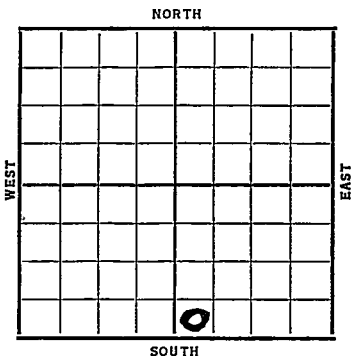

Date	REPORT
1937	
7/21	R.U.R.
7/30	10" @ 444'. WOG.
8/6	Drlg. 2280'.
8/13	Topeka 2660'. S.O. 2884-90'. S.O. 2967-76'. Drlg. 2982'.
8/20	Sil. 3200'. T.D. 3207'. 6" @ 3200'. Sat. Core.
	RUST.
8/28	"
9/3	T.D. 3207'. 1800' oil in 6 hrs. Total fill up 2700'. Pumped 12 BOPH. 1000 acid. Pumped 248 BO 6 hrs. 1500 A Pumped 237 BO 4 hrs.
	OVER

1937

9/8

6" @ 3200'.

Silicious 3200'.

T.D. 3207'.

1000 acid. P. 248 bbls. 6 hrs.

1500 acid. P. 237 bbls. 4 hrs.

P. 233 bbls. 4 hrs.

232 bbls. 4 hrs.

Potential 1395 bbls.

COMPLETED

Russell

Map No. 73 Sec. 8 Twp. 15 R. 13^WWell No. 6 - DetrichCarter Company

Contractor

FIRST REPORT

SECTION PLAT

_____ Ft. from N. Line

330 Ft. from S. Line330 Ft. from E. Line330 Ft. from W. Line

		0	

Location _____

Rig up _____

Drilling and Remarks:

R. U. R.

RECORD

Cased _____ in., _____ ft.

Sand _____

Gas _____

Oil _____

Total Depth _____

PRODUCTION

1st 24 hrs. Nat. _____

1st 24 hrs. after shot _____

Gas _____ Cu. Ft.

Dry Hole _____

Abandoned _____

Date

11: 21 1907 19

H. D. Hatfield, Scout

Map No. _____ Sec. 8 Twp. 15 R. 13WWell No. 6 - Detrich
Carter oil Company _____

Contractor _____

COMPLETED

SECTION PLAT

		0	

_____ Ft. from N. Line

330 Ft. from S. Line

_____ Ft. from E. Line

330 Ft. from W. Line

Location _____

RECORD

Cased, 6 in., 3200 ft.Sand 3200

Gas _____

Oil _____

Total Depth 3207

Drilling and Remarks:

1000 cu ft. P. 248 bbls 6 hrs
1500 cu ft. P. 237 bbls 4 hrsP. 233 4 hrs
P. 232 " "Prod. 1395 bbls

PRODUCTION

1st 24 hrs. Nat. _____

1st 24 hrs. after shot. _____

Gas _____ Cu. Ft.

Dry Hole _____

Abandoned _____

Date

SEP 8 1937 19H. D. Hatfield

Scout