

KALONS


Russell

Section 8 Township 15 Range 13W

Well No. 3 Rein

Company Gulf

Trapp

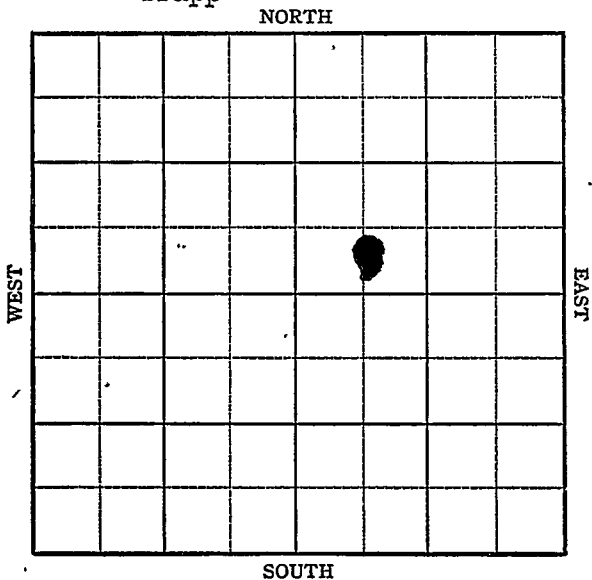

Sec. 8 Twp. 15 R. 13W ✓

Well No. #3 Rein Farm \_\_\_\_\_

Gulf Company


Trapp Pool

\_\_\_\_\_ Ft. from N. Line

480' Ft. from S. Line

\_\_\_\_\_ Ft. from E. Line

660' Ft. from W. Line

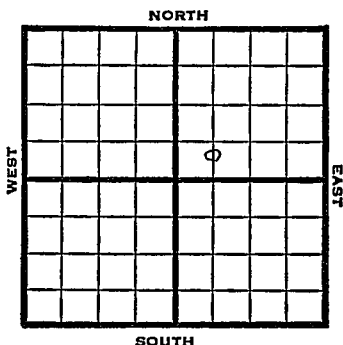

C S L SW NE

1949 Elev 1746' REPORT

1/19 Location  
1/26 8" @ 707'  
2/2 Lansing 2903  
Drlg. 2943'  
2/9 5" @ 2917  
TD 2942'  
2/16 500 acid  
Swb 14 bbls oil 8 hrs.  
2/23 TD 3008'  
2000 acid  
Swb 12 fluid PH 6 hrs.  
40% W  
3/2 Swb 144 bbls oil 18 hrs.  
3/8 "  
3/16 "  
3/23 TD 3008'  
Lans. 2905'  
5" @ 2917'  
2500 acid  
Pump 287 Oil / 4% W Pot  
40<sup>9</sup> Gr.  
Comp

**COMPLETED**

Map No. \_\_\_\_\_ Sec. 8 Twp. 15 R. 13W

Well No. 3 Rein

Gulf Company

1st REPORT Contractor

C S L SW NE

SECTION PLAT

\_\_\_\_\_ Ft. from N. Line

480 Ft. from S. Line

\_\_\_\_\_ Ft. from E. Line

660 Ft. from W. Line


Russell County

RECORD

Location \_\_\_\_\_ X

Cased \_\_\_\_\_ in., \_\_\_\_\_ ft.

Rig up \_\_\_\_\_

Sand \_\_\_\_\_

Drilling and Remarks:

Gas \_\_\_\_\_

Oil \_\_\_\_\_

Total Depth \_\_\_\_\_

PRODUCTION

1st 24 hrs. Nat. \_\_\_\_\_

1st 24 hrs. after shot \_\_\_\_\_

Gas \_\_\_\_\_ Cu. Ft.

Dry Hole \_\_\_\_\_

Abandoned \_\_\_\_\_

Date

JAN 19 1949 19

S. I. LEWIS Scout

Kansas

Map No. 73 Sec. 8 Twp. 15 R. 13WWell No. 3 Rein

Gulf

Company

COMPLETE

Contractor

C S L SW NE

*E. 11746*  
SECTION PLAT       Ft. from N. Line480 Ft. from S. Line       Ft. from E. Line660 Ft. from W. Line


Russell County

Location \_\_\_\_\_

Rig up \_\_\_\_\_

Drilling and Remarks:

*None 2905**5" @ 2917**2500 ac coal**Pump: 2870 ft + 4%**PT**40 2/3*

## RECORD

Cased \_\_\_\_\_ in., \_\_\_\_\_ ft.

Sand \_\_\_\_\_

Gas \_\_\_\_\_

Oil \_\_\_\_\_

Total Depth 3005

## PRODUCTION

1st 24 hrs. Nat. \_\_\_\_\_

1st 24 hrs. after shot \_\_\_\_\_

Gas \_\_\_\_\_ Cu. Ft.

Dry Hole \_\_\_\_\_

Abandoned \_\_\_\_\_

Date

MAR 23 1949 19

S. J. LEWIS

Scout