

KANSAS


Russell

Form 51-5M-4-36-Palace

Section 8 Township 15 Range 13-W

Well Number #1 Detrick

Company Carter Oil

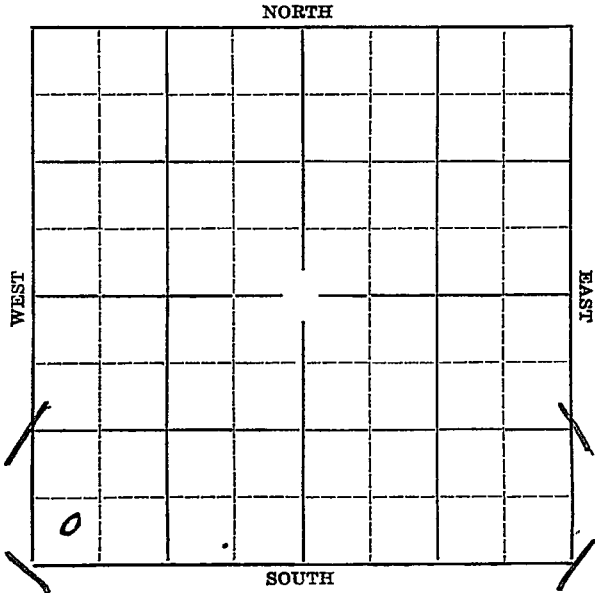

O. W. D. D

Sec. 8 Twp. 15 R. 13W

Well No. #1 Detrick Farm

Carter Oil Company


 Ft. from N. Line

330' Ft. from S. Line

 Ft. from E. Line

330' Ft. from W. Line

Elev. 1779

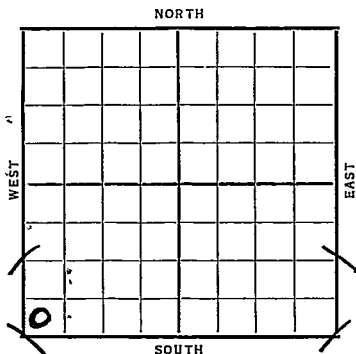

Date	REPORT O. W. D. D
10/28	Location.
11/6	Rig
11/12	Rigging up.
11/19	12" @ 323'. Drlg. 723'.
11/27	Anhydrate 780'. Drlg. 2330'.
12/3	Topeka 2630'. Cored 2740-43' show oil. Rust.
12/10	Bailing mud.
12/17	Show oil 2788-94'. Pay 2878-88'. 1100' oil in hole.
12/24	---
12/29	3000 acid. Flow 210 oil 6 hr
1937	
1/7	" " " " " "
1/14	Flow 217 bbls. 24 hrs.
1/21	Shut down.
1/28	3000 acid. No test.
2/4	Flow 150 bbls 2 hrs. 8% B.S.
2/11	" " " " "
2/19	" " " " "
	OVER

1937

2/24 Topeka 2630'.

Pay 2878-88'.

T. D. 2888'.

3000 acid.

3000 acid.

Potential flow 389 oil 1.8%
water.

COMPLETED

O. W. D. L

1937

7/21 .OTD 2888'

C.O. to deepen

7/30 K.C. 2934'. T.D. 2944'.

Rng. 7".

8/6 7" @ 2944'. Est. 4 M gas 2950-57'.

Oil Pay 2962-75'. T.D. 2980'.

Flowed 19 bbls. oil per hour 12 hrs.

8/11 7" @ 2944'.

K.C. 2934'.

T.D. 2980'.

1000 acid.

Pot. 1542 bbls.

COMPLETED

1938

O. W. D. D.

1/19 Old T.D. 2980'.

R. U. to deepen.

1/28 Arb. 3206-11 T.D. S.O. Rng.csg.

2/4 7" 3207' RUST.

OVER

1938

2/11 Pump 550 oil in 8 hrs.

2/16 7" @ 3207'.

Arb. 3206'.

T.D. 3211'.

Potential 1750 bbls., Nat.

COMPLETED

KANSAS

Map No. 73 Sec. 5 Twp. 15 R. 13W

Well No. 1 De trap

Cartes Oil Company

Contractor _____

SECTION PLAT

_____ Ft. from N. Line

330 Ft. from S. Line

_____ Ft. from E. Line

330 Ft. from W. Line

FIRST REPORT

Location ✓

Rig up _____

Drilling and Remarks:

RECORD

Cased _____ in., _____ ft.

Sand _____

Gas _____

Oil _____

Total Depth _____

PRODUCTION

1st 24 hrs. Nat. _____

1st 24 hrs. after shot _____

Gas _____ Cu. Ft.

Dry Hole _____

Abandoned _____

Date

OCT 28 1936

19

S. J. LEWIS

Scout

Russell

Map No. _____ Sec. 8 Twp. 15 R. 13W

Well No. 1 Detrich

Cartel Company

Contractor _____

SECTION PLAT

0			

i
_____ Ft. from N. Line

330 Ft. from S. Line

_____ Ft. from E. Line

330 Ft. from W. Line

COMPLETED

Location _____

Rig up _____

Drilling and Remarks:

Topeka 2630

Pay 2878-88

3000 acid

3000 acid

Potential flow

389 oil 1.8% water

RECORD

Cased _____ in., _____ ft.

Sand _____

Gas _____

Oil _____

Total Depth 2888

PRODUCTION

1st 24 hrs. Nat. _____

1st 24 hrs. after shot _____

Gas _____ Cu. Ft.

Dry Hole _____

Abandoned _____

Date _____

FEB 2 1931

S. J. LEWIS Scout

Russell

Map No. 73 Sec. 8 Twp. 15 R. 13W

Well No. 1-Detrick

Carter Company

Contractor

FIRST REPORT

SECTION PLAT

330 Ft. from N. Line
330 Ft. from S. Line
330 Ft. from E. Line
330 Ft. from W. Line

0			

- 0W0D -

Location _____

Rig up _____

Drilling and Remarks:

OTD 2888
C.O. To Deepen

RECORD

Cased _____ in., _____ ft.

Sand _____

Gas _____

Oil _____

Total Depth _____

PRODUCTION

1st 24 hrs. Nat. _____

1st 24 hrs. after shot _____

Gas _____ Cu. Ft.

Dry Hole _____

Abandoned _____

Date

JUL 21 1937 19

H. D. Hatfield Scout

KANSAS

Russell

Map No. _____ Sec. 8 Twp. 15 R. 13^w

Well No. 1 - Detrick

Carter

Company

Contractor

COMPLETED

SECTION PLAT

_____ Ft. from N. Line

330 Ft. from S. Line

_____ Ft. from E. Line

330 Ft. from W. Line

0			

OWDD

Location _____

Rig up _____

Drilling and Remarks:

1000 Acid

Pot - 1542

RECORD

Cased 7 in., 2944 ft.

~~Sand~~ K.C. 2934

Gas _____

Oil _____

Total Depth 2980

PRODUCTION

1st 24 hrs. Nat. _____

1st 24 hrs. after shot _____

Gas _____ Cu. Ft.

Dry Hole _____

Abandoned _____

Date

AUG 11 1937 19

H. D. Hatfield Scout

Map No. 73 Sec. 8 Twp. 15 R. 13WWell No. 1 DetrickCarter Oil Company

Contractor

FIRST REPORT

SW/C

_____ Ft. from N. Line

330 Ft. from S. Line

_____ Ft. from E. Line

330 Ft. from W. Line**SECTION PLAT**

Location _____

Rig up _____

Drilling and Remarks:

OWDD - OTD 2980

RUR to deepen

RECORD

Cased _____ in., _____ ft.

Sand _____

Gas _____

Oil _____

Total Depth _____

PRODUCTION

1st 24 hrs. Nat. _____

1st 24 hrs. after shot _____

Gas _____ Cu. Ft.

• Dry Hole _____

Abandoned _____

Date

JAN 19 1938 19H. D. Hatfield Scout

