

# KANSAS

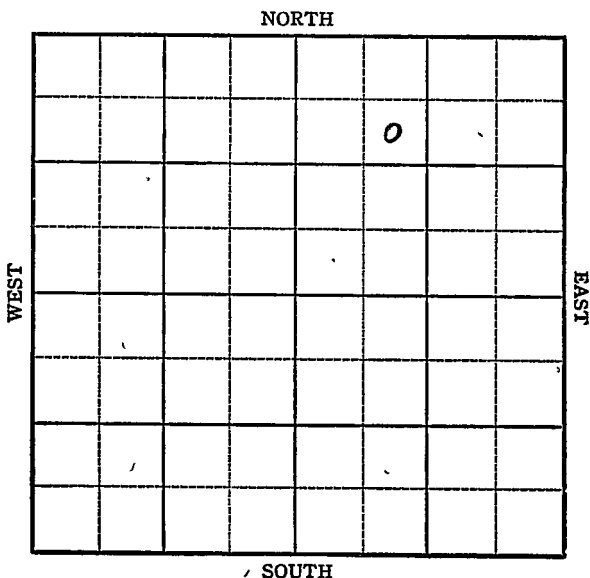
FORM 51 5M PETROL

Russell

Section 8 Township 15 Range 13-W

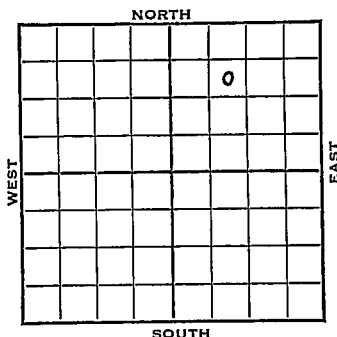
Well No. #2 Rein

Company HOLLAND  
Irwin Drilling



KANSAS

Russell

Sec. 8 Twp. 15 R. 13-WWell No. #2 Rein Farm  
Holland  
Irwin Drilling Company990 Ft. from N. Line       Ft. from S. Line       Ft. from E. Line990 Ft. from W. Line

1943

*elev. 1760*

REPORT

8/18 Rotary

8/25 8" @ 475'

Anhy 710'

Drlg. 2741'

9/1 Arb 3270-72 T.D.

5" @ 3270

Rust

9/8 Topeka 2620

Lans 2930

Arb 3221 Corrected

T.D. 3271

5" @ 3269

Rust

9/15 T.D. 3272'

70' oil in 2 hrs.

9/22 Packer 3134

15 shots 3069-74-3000 acid

HFO in 4 hrs.

9/29 " " "

10/6 " " "

10/13 " " "

10/20 " " "

10/27 " " "

11/3 " " "

OVER

1943  
11/10

Arb 3221  
5" @ 3269  
Lans 2930  
Perf. Lans  
3000 acid  
Pump 174 Pot.  
T.D. 3272'  
Gravity 36.7

COMPLETED

**KANSAS**Map No. 73 Sec. 8 Twp. 15 R. 13WWell No. 2 ReinIrwin Drilling

Company

FIRST REPORT

Contractor

**SE NW NE****990**

Ft. from N. Line

Ft. from S. Line

Ft. from E. Line

**990**

Ft. from W. Line

**TRAP P POOL****SECTION PLAT**

|  |  |   |  |
|--|--|---|--|
|  |  |   |  |
|  |  | o |  |
|  |  |   |  |
|  |  |   |  |
|  |  |   |  |

Location

Rig up

Drilling and Remarks:

**Rotary****RECORD**

Cased \_\_\_\_\_ in., \_\_\_\_\_ ft.

Sand \_\_\_\_\_

Gas \_\_\_\_\_

Oil \_\_\_\_\_

Total Depth \_\_\_\_\_

**PRODUCTION**

1st 24 hrs. Nat. \_\_\_\_\_

1st 24 hrs. after shot \_\_\_\_\_

Gas \_\_\_\_\_ Cu. Ft.

Dry Hole \_\_\_\_\_

Abandoned \_\_\_\_\_

Date

**AUG 1 8 1943**

19

**S. J. LEWIS**

Scout

KANSAS

Map No. 73 Sec. 8 Twp. 15 R. 13WWell No. 2 ReinHolland et al. Company

CORRECTION

Contractor

SE NW NE

990 Ft. from N. Line       Ft. from S. Line       Ft. from E. Line990 Ft. from W. Line

## SECTION PLAT

|  |  |   |  |
|--|--|---|--|
|  |  |   |  |
|  |  | o |  |
|  |  |   |  |
|  |  |   |  |
|  |  |   |  |

Trapp Pool

Location       Rig up       

Drilling and Remarks:

Holland taken  
over from  
Irwin Drilling

## RECORD

Cased        in.,        ft.Sand       Gas       Oil       Total Depth       

## PRODUCTION

1st 24 hrs. Nat.       1st 24 hrs. after shot       Gas        Cu. Ft.Dry Hole       Abandoned       

Date

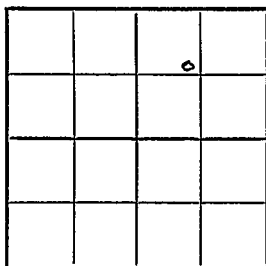
SEP 29 1943 19S. J. LEWIS Scout

KANSAS

Map No. 3 Sec. 8 Twp. 15 R. 13WWell No. 2 ReinHolland CompanyCOMPLETED Contractor

SE NW NE

## SECTION PLAT

990 Ft. from N. Line       Ft. from S. Line       Ft. from E. Line990 Ft. from W. LineTrapp PoolLocation                                 Rig up                                 

Drilling and Remarks:


## RECORD

Cased            in.,            ft.Sand                                 Gas                                 Oil                                 Total Depth 3272

## PRODUCTION

1st 24 hrs. Nat.                                 1st 24 hrs. after shot                                 Gas                                  Cu. Ft.Dry Hole                                 Abandoned                                 

Date

NOV 10 1943 19S. J. LEWIS Scout