

O. W. P. B

KANSAS


Russell

FORM 51 5M 4-41 PETROL

Section 8 Township 15 Range 13-W

Well No. #15 Detrich (Twin #6)

Company Carter

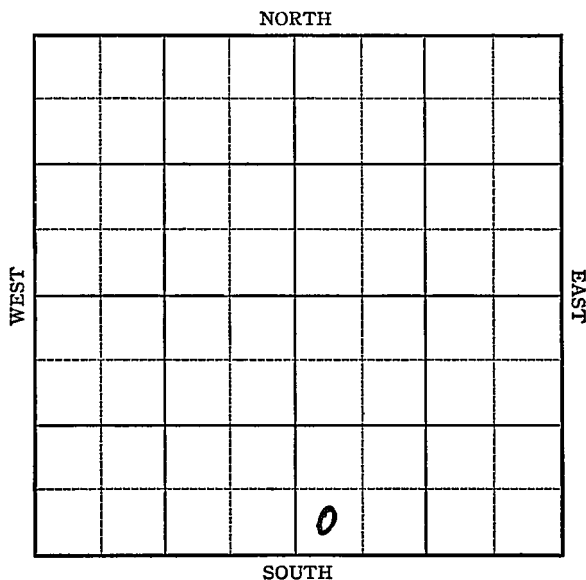


KANSAS

Russell

O. W. P. B

Sec. 8 Twp. 15 R. 13-WWell No. #15 Detrich (Twin #6) FarmCarter Company(Coralena) *Trapp* Ft. from N. Line405 Ft. from S. Line Ft. from E. Line330 Ft. from W. Line
SW SW-SE

Elev. 1770

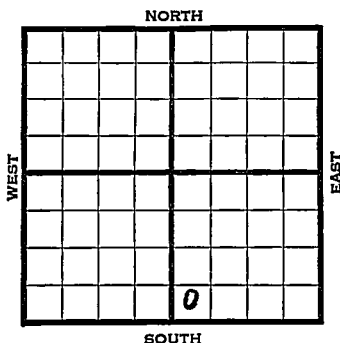

1941

REPORT

9/24

Rotary.

10/2

8" - 247' Drlg. 2750'

10/9

Dodge 2879' Lans. 2920'

5" - 2931' T.D. 2977'

186' oil.

10/16

5000 acid.

10/23

" "

10/30

" "

11/6

" "

11/13

" "

11/19

Lans. 2920'

5" - 2931'

T.D. 2977'

5000 acid.

Depthograph potential 1075 bbls.

39. Gravity

~~1955~~

COMPLETED

O. W. P. B

OVER

1955

8-31-

OTD 2977

5" @ 2931

PB 2902, 40/ 2872-82, 1500 A

S/ 1 bo 13 gsw, 16 $\frac{1}{2}$ hr.

PB 2811, 32/ 2567-75, 4 $\frac{1}{2}$ gw 2000 A

B/ 5.59 go 37 gw 5 hr.

B/ 13.36 gw 34 gsw 8 hr.

D & A

Dg. Dodge 2879 , L. 2920

FIRST REPORT

f
ABANDONED
~~COMPLETED~~

Russell

KANSAS

Map No. K-73 Sec. 8 Twp. 15 R. 13WWell No. 15 Detrich (Twin #6)Carter

Company

FIRST REPORT

Contractor

SW SE

SECTION PLAT

 Ft. from N. Line405 Ft. from S. Line Ft. from E. Line330 Ft. from W. Line

CORALENA POOL

Location Rig up

Drilling and Remarks:

Rotary

RECORDCased in., ft.Sand Gas Oil Total Depth **PRODUCTION**1st 24 hrs. Nat. 1st 24 hrs. after shot Gas Cu. Ft.Dry Hole Abandoned

Date

SEP 24 1941

19

S. J. LEWIS Scout

Map No. K-93 Sec. 8 Twp. 15 R. 13WWell No. 15 Detrich (Twin #6)Carter CompanyCOMPLETED Contractor

SW SE

SECTION PLAT

 Ft. from N. Line405 Ft. from S. Line Ft. from E. Line330 Ft. from W. Line

		o	

CORALENA POOL

Location Rig up

Drilling and Remarks:

*Lane 2920**5' @ 2931**5000 acid**Dep't # 1075**39° S*

RECORD

Cased in., ft.Sand Gas Oil Total Depth 2977

PRODUCTION

1st 24 hrs. Nat. 1st 24 hrs. after shot Gas Cu. Ft.Dry Hole Abandoned

Date

NOV 19 1941

19

S. J. LEWIS

Scout

O. W. P. B.

FORM 513 REV. SUNRAY

OWPB

County Russell Elev. 1770
 Sec. 8 Twp. 15 Rge. 13W
 Company Carter Oil
 FarmName J. Detrich No. 15

TOPS	DEPTH	LOG	DATUM	Loc. in Sec.
Anh.				SW SW SE
Tr.				
H.				
Tr. <u>Dodge</u>	<u>2879</u>			
Dg.				
Bl.	<u>2920</u>			
L.				Geol.
K.C.				Contr.
B.K.C.				
Ce.				
C.				Pool
M.				Trapp
M.				
K.				
Mz.				
Me.				
V.				
S.				
S.				
A.				
R.				
Pe.				
G.				
T.D.				

ABG 31 '55
 FIRST REPORT
 ABANDONED

Date Comm. OTD 2977 5" @ 2931 PB 2902
40/ 2872-82 1500 A S/ 1 bo 13 gsw
16 $\frac{1}{2}$ hr. PB 2811 32/ 2567-75
4 $\frac{1}{2}$ gw 2000 A B/ 5.59 go 37 gw 5 hr.
B/ 13.36 gw 34 gsw 8 hr.

D & A