


Section 33 Township 16 Range 12W

Well No. #1 Prosser

Company Addis & Boxberger

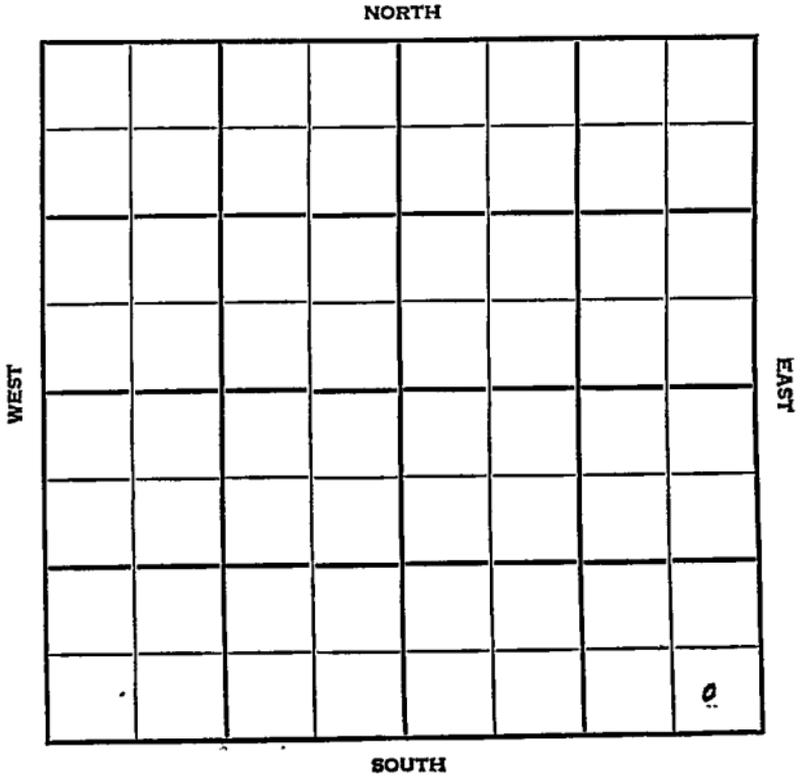


SEC. 33	TWP. 16	R. 12W
------------	------------	-----------

WELL NO. #1 Prosser FARM

COMPANY Addis & Boxberger

CONTRACTOR Mast Drlg.  
Odin Pool

\_\_\_\_\_ Ft. from N. Line  
330 \_\_\_\_\_ Ft. from S. Line  
330 \_\_\_\_\_ Ft. from E. Line  
\_\_\_\_\_ Ft. from W. Line

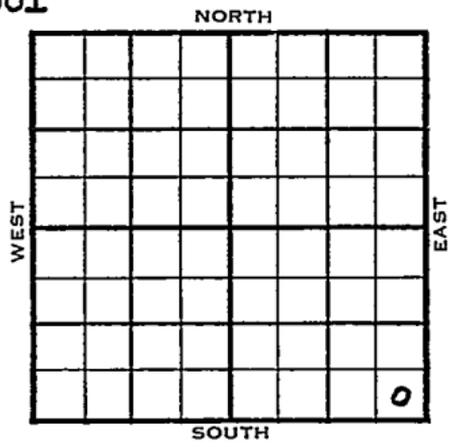


SE SE SE

	ELEVATION	REPORT
1954	1854	
9/1		Spud 8-26-54 8" @ 201' Anhy 731' Drlg. 2003'
9/29		Spud 8-26-54 - Oil Well TD 3336' 8" @ 201' Anhy 731' DST 3310-14', opn 45", rec. 22' mud, 725# DST 3316-20', opn 1 hr., rec. 10' mud, 8' oil 0# oil DST 3319-23', opn 1 hr., rec. 10' / <del>mud</del> 15' mud, 550# DST 3323-36', opn 1/2 hrs., rec. 750' oil, 850# TD 3336' 5" @ 3335' Heeb 2950', Br lime 3041', Lans 3056', Arb. 3316' CO to 3335' 24/3329-32, FU 950' oil, 100' wtr, 12 hrs., S/3 boph 10% wtr. Comp. 46 bopd

**COMPLETED**



County Barton State Kansas  
 Sec. 33 (Blk. 16) (Sur. 12W) (Twp.) (Rge.) Map No.  
 Operator Addis & Boxberger  
 Well No. 1 Farm Prosser  
 Elev. 1854 Location SE SE SE

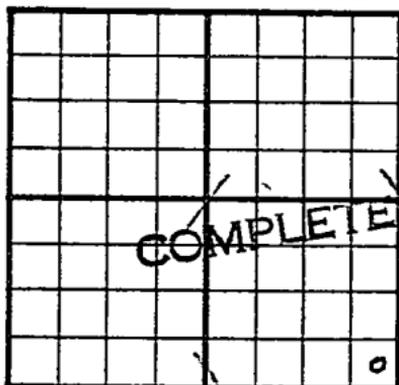

330 Ft. From S Line SE  
330 Ft. From E Line Quarter  
 Ist. Report Sep 1 1954  
 Completion SEP 29 1954  
 Remarks  
Mast Drlg. - Contr.  
 Spudding Date 8-26-54

Drlg. Data Oil well TD 333@din Pool  
8" @ 201 Anhy 731 DST 3310-14  
open 45 min. Rec. 22' mud 725# DST  
3316-20 open 1 hr. Rec. 10' mud  
8' oil 0# DST 3319-23 open 1 hr.  
Rec. 10' oil 15' mud 550# DST 3323-36  
open 1/2 hr. Rec. 750' oil 850# TD 3336  
5" @ 3335 Heeb. 2950 Br. lime 3041  
lans. 3056 Arb. 3316 CO to 3335  
24/ 3329-32 FU 950' oil 100' wtr. 12 hr  
S/ 3 boph 10% wtr. Comp. 46 bopd

FABEN GILSTRAP