


Section 8 Township 15 Range 13W

Well No. #2 Rain

Company B & R Drlg.

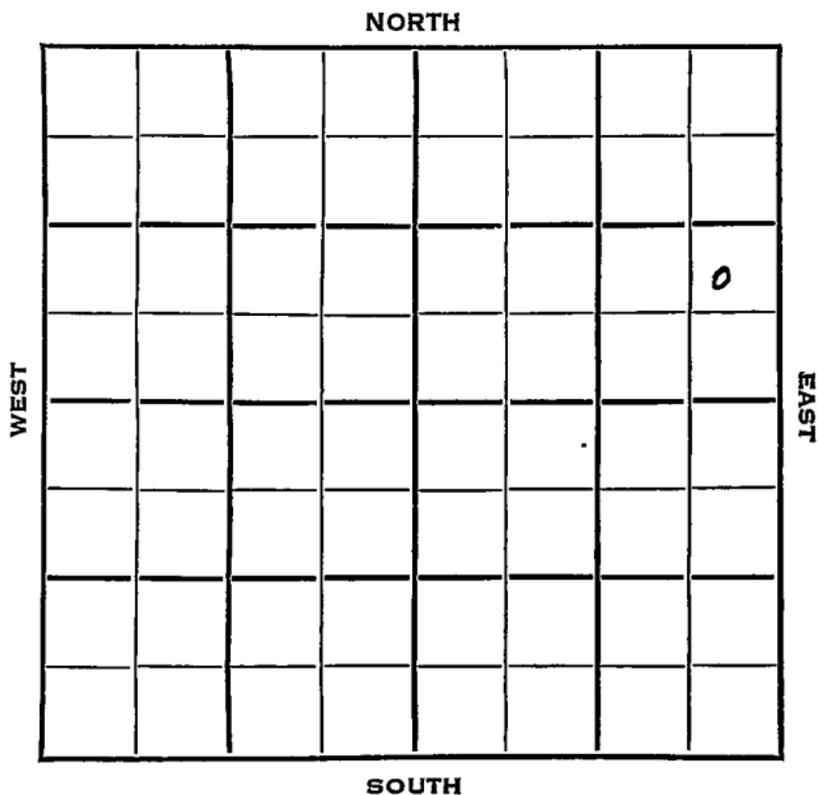

County **Russell** State **Kansas**

Sec. **8** (Blk Twp) **15** (Sur. Rge.) **13W** Map No.

Operator **B & R Drlg.**

Well No. **2** Farm **Rein**

Elev. **1878** Location **NE SE NE**

							0

990 Ft. From **S** Line **NE**

330 Ft. From **E** Line **Quarter**

Ist. Report **MAR 31 1954**

Completion

Remarks **Gulf farmout**

Spudding Date **3-18-54**

Drlg. Data **Trapp Pool**

8" @ 488 Top* **2740** Heeb* **2976**

Dodge 2993 **KC 3044** **Arb* 3324**

TD 3325 **5" @ 3325**

J. G. McGE...

