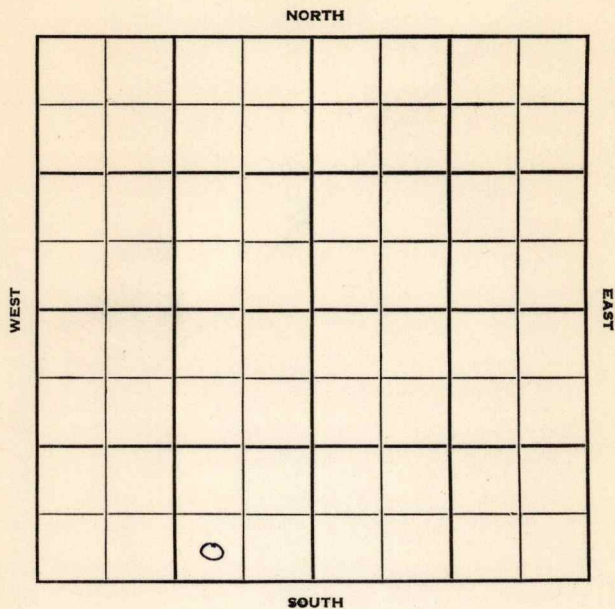


Section 7 Township 12 Range 15WWell No. #7 HollandCompany Stearns Pet.

Russell KANSAS

Sec. 7 Twp. 12 R. 15 W

Well No. # 7 Holland Farm

Stearns Pet. Company

Contractor

Fairport


Ft. from N. Line

330 Ft. from S. Line

990 Ft. from E. Line

Ft. from W. Line

SW SE SW

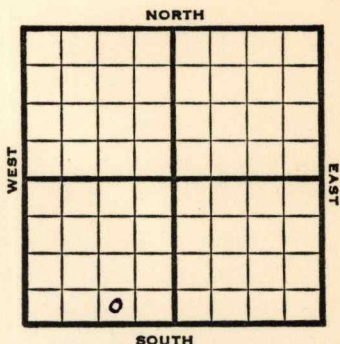

1952

Elev. 1777'

REPORT

1/30

Spud 1-24-52

8" @ 198

Anhy 911'

Drlg. 1260'

2/6

Drlg. 2980'

8" @ 198

Heeb. 2969'

2/13

Spud 1-24-52

D&A TD 3428

8" @ 198

Anhy 911

Tar 2490

Dodge 2990

B KC 3290

Arb. 3385

TD 3428

D&A

Heeb. 2969

Top. 2704

Lans. 3021

Cong. 3329

ABANDONED

County Russell State Kansas

Sec. 7 (Blk. Twp.) 12 (Sur. Rge.) 15W Map No.

Operator Stearns Pet.

Well No. 7 Farm Holland

Elev.	1777	Location	SW SE SW
-------	------	----------	----------

ABANDONED

330 Ft. From S Line SW

990 Ft. From E Line Quarter

1st. Report

Completion FEB 13 1952

Remarks	Fairport Pool
---------	---------------

Spudding Date 1-24-52

Drig. Data D & A TD 3428

8" @ 198 Anhy 911 Heeb. 2969

Tarkio 2490 Top. 2704 Dodge 2990

Lans. 3021 B KC 3290 Cong. 3329

Arb. 3385 TD 3428

D & A

J. G. McGEHEE