
FORM 51 5M BRIX KANSAS

Barton

Section 33 Township 16 Range 12W

Well No. #1 Schneweiss

Company Western Exploration

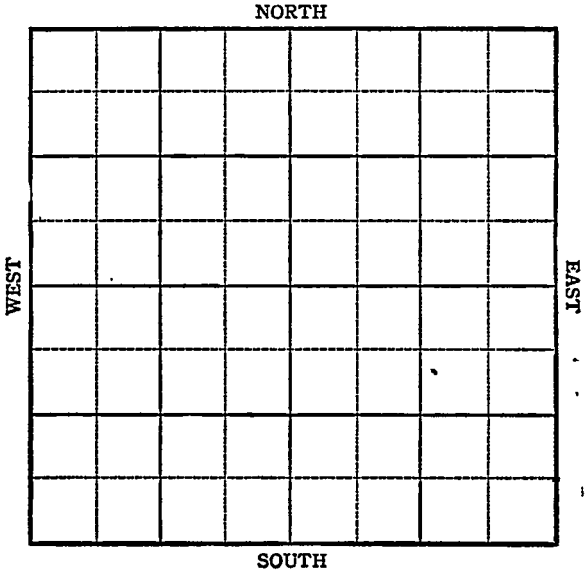

FORM 252-A
5M 3-44 PETRO

KANSAS Barton

Sec. 33 Twp. 16 R. 12W

Well No. #1 Schneweiss Farm

Western Exploration Company

Feltes


330 Ft. from N. Line

Ft. from S. Line

Ft. from E. Line

330 Ft. from W. Line

Elev. 1887

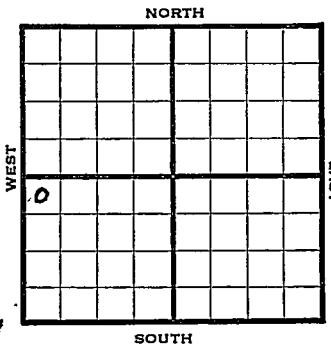

1944	REPORT
8/2	8" @ 270' WOC
8/9	Drlg. 2462
8/16	Topeka 2777 Lans 3103 Arb 3368 TD 3400
	ABANDONED

FORM 26 200 BKS. 2-44 PETROL

KANSAS

Pool Name Feltes

Map No. 17 Sec. 33 Twp. 16 R. 12W

Well No. 1 Schneweiss

Western Exploration Company

FIRST REPORT Contractor

NW SW

330 Ft. from N. Line


Ft. from S. Line

Ft. from E. Line

330 Ft. from W. Line

Barton County

SECTION PLAT

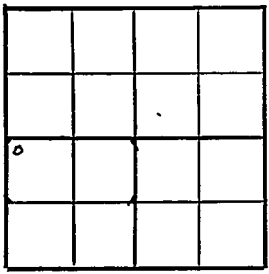

Location

Rig up

Drilling and Remarks:

8" - 270 WOC

RECORD

Cased in., ft.

Sand

Gas

Oil

Total Depth

PRODUCTION

1st 24 hrs. Nat.

1st 24 hrs. after shot

Gas Cu. Ft.

Dry Hole

Abandoned

Date

AUG 2 1944 19

S. J. LEWIS Scout

FORM 26 200 BKS. 2-44 PETROL

KANSAS Pool Name Feltes Pool

Map No. JJ Sec. 33 Twp. 16 R. 12W


Well No. 1 Schneweiss

Western Pet. Exploration Company

ABANDONED Contractor

NW SW

SECTION PLAT

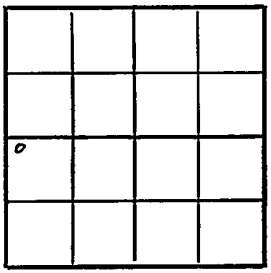

330 Ft. from N. Line

_____ Ft. from S. Line

_____ Ft. from E. Line

330 Ft. from W. Line

Barton

Location _____

Rig up _____

Drilling and Remarks:

Topeka 2777

Lans 3103

CE 3368

RECORD

Cased ____ in., ____ ft.

Sand _____

Gas _____

Oil _____

Total Depth 3400

PRODUCTION

1st 24 hrs. Nat. _____

1st 24 hrs. after shot _____

Gas _____ Cu. Ft.

Dry Hole _____

Abandoned _____

Date

AUG 16 1944 19 ____ S. J. LEWIS Scout