


Section 7 Township 15 Range 13W

Well No. #8 Anderson

Company Skelly Oil Company

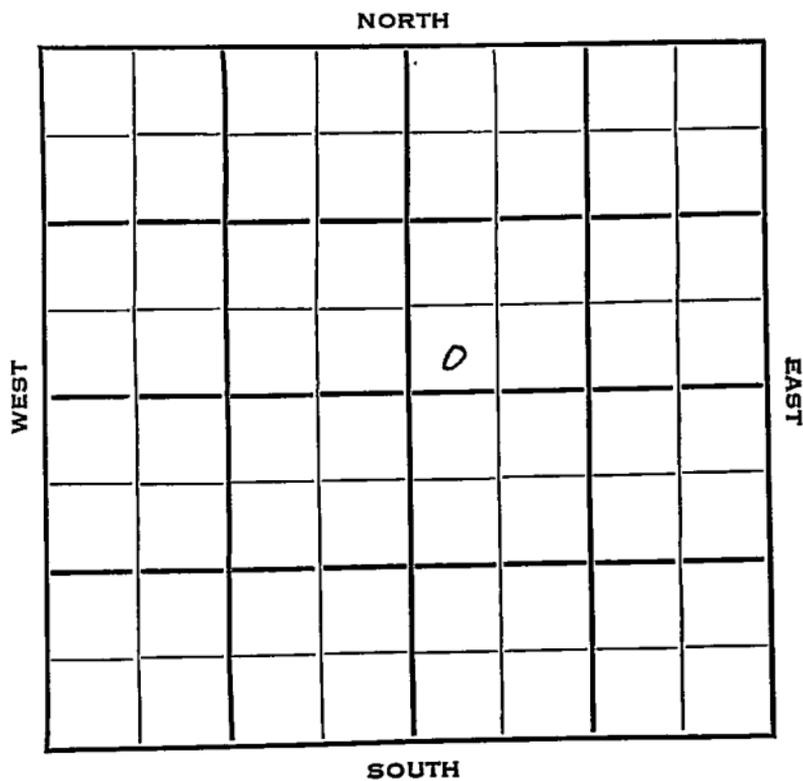

Russell

KANSAS

Sec. 7 Twp. 15 R. 13 W

Well No. # 8 Anderson Farm

Skelly Oil Company

Contractor

Ft. from N. Line

330


Ft. from S. Line

Ft. from E. Line

330

Ft. from W. Line

SW SW NE

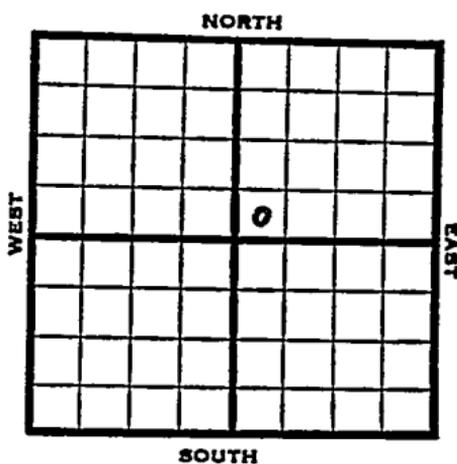

1953

Elev. 1849' REPORT

3/11

Location

3/19

Anhy 833' 8" @ 834
Drlg. 1765'

3/26

Drlg. 3124'

4/1

Spud 3-11-53
Oil well

TD 3306'

Anhy 833

8" @ 834'

Tarkio 2392, Top 2723, Heeb 2958, Tor. 2978, Doug 2990, Lans 3027, Arb 3300, TD 3303

5" @ 3301'

DD 3306

2 1/2 boph 2 hr. & SSW

Comp. 71 bopd

COMPLETED

