

KANSAS

Form 51-5M-11-38-Palace


Russell

Section 8 Township 15 Range 13-W

Well No. #5 Rein

Company Skelly

NORTH Coralena Pool

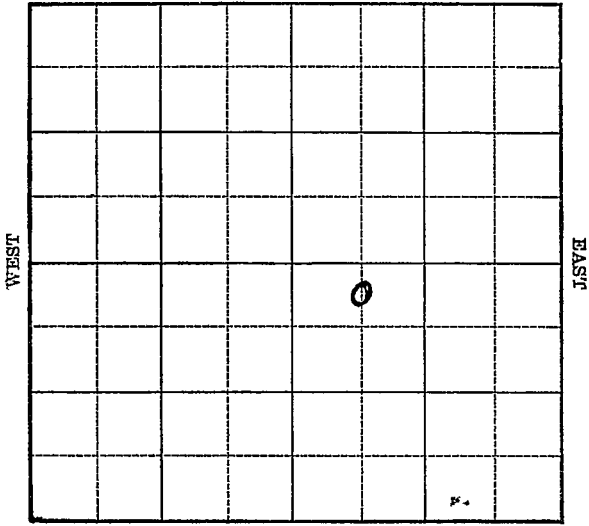

SOUTH

Sec. 8 Twp. 15 R. 13-W

Well No. #5 Rein Farm

Skelly Company


(Coralena)

330 Ft. from N. Line

_____ Ft. from S. Line

_____ Ft. from E. Line

660 Ft. from W. Line

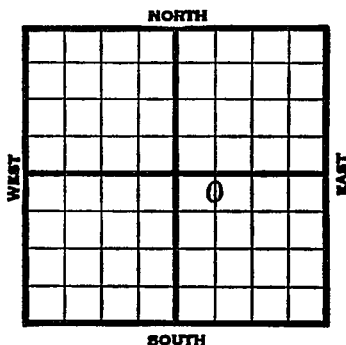

Elev. 1796

1939	REPORT
11/1	Rotary.
11/9	10" - 251' Drlg. 775'
11/16	Drlg. 2356'
11/23	Lans. 2954' Arb. 3227'
	T.D. 3230' S.O. Run 5".
11/29	5" - 3028' C.O.
12/7	T.D. 3238' 4000 acid.
	Pump 109 bbls. 4 hours.
12/14	3500 acid. Pump 168 bbls. 8
	hours.
12/20	Arb. 3227'
	5" - 3028'
	T.D. 3238'
	8000 acid.
	Potential 504 bbls., pump.
	COMPLETED

Map No. 73 Sec. 8 Twp. 15 R. 13W

Well No. 5 Rein

Skelly

Company

Contractor

FIRST REPORT

. SECTION PLAT

C N L NW SE

330 Ft. from N. Line

_____ Ft. from S. Line

_____ Ft. from E. Line

660 Ft. from W. Line

		o	

CORALENA POOL

Location _____

Rig up _____

Drilling and Remarks:

Rotary

RECORD

Cased _____ in., _____ ft.

Sand _____

Gas _____

Oil _____

Total Depth _____

PRODUCTION

1st 24 hrs. Nat. _____

1st 24 hrs. after shot _____

Gas _____ Cu. Ft.

Dry Hole _____

Abandoned _____

Date

NOV 1 1939

S. J. LEWIS Scout

Map No. 73 Sec. 8 Twp. 15 R. 13WWell No. 5 ReinSkelly

Company

Contractor

COMPLETED

C N L NW SE

330 Ft. from N. Line

_____ Ft. from S. Line

_____ Ft. from E. Line

660 Ft. from W. Line

CORALENA POOL

SECTION PLAT

		0	

Location _____

Rig up _____

Drilling and Remarks:

*Oil 8.3227**5" @ 3028.**1000 and**Pump 504 P.S.***RECORD**

Cased _____ in., _____ ft.

Sand _____

Gas _____

Oil _____

Total Depth 3238**PRODUCTION**

1st 24 hrs. Nat. _____

1st 24 hrs. after shot _____

Gas _____ Cu. Ft.

Dry Hole _____

Abandoned _____

Date

DEC 20 1939 19S. J. LEWIS Scout