


Section 7 Township 15 Range 13W

Well No. 4 Maag

Company Derby Oil et al

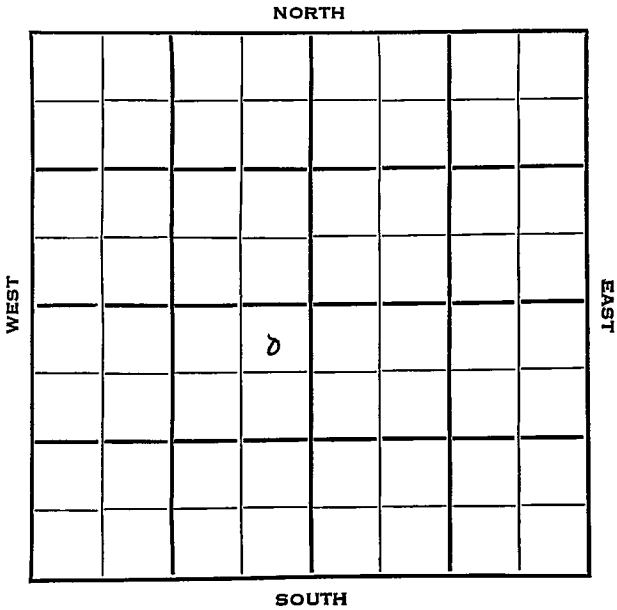

Sec. 7 Twp. 15 R. 13 W

Well No. # 4 Maag Farm _____

Derby Oil et al Company _____

Trapp Pool Contractor _____


330 Ft. from N. Line

_____ Ft. from S. Line

330 Ft. from E. Line

_____ Ft. from W. Line

NE NE SW

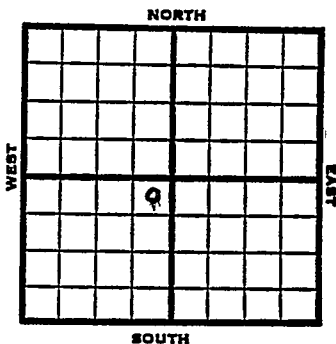

1953

Elev. 1862' REPORT

2/4
2/12

RUR
8" @ 448
Drlg. 2960'

2/19

Heeb 2976 Lans 3041
DST 3081-88, 3/4 hr, 15' M
Arb 3315'-18' TD 5" @ 3316

2/26

CO 3318' S/53 BOPH 8 hrs. 300 A
S/ 3 BOPH 5 hrs. POP

3/4

Spud 2-3-53
Oil Well
TD 3318
8" @ 448
Heeb 2976, Lans 3041
DST 3081-88, opn 3/4 hrs., rec.
15' mud,
Arb 3315
TD 3318
5" @ 3316
CO to 3318, S/53 goph 8 hrs.
300A S/3 boph 5 hrs.
Comp. 132 bopd 1% wtr.

COMPLETED

