

Section 8 Township 15 Range 13WWell No. #9 AndersonCompany Skelly Oil

NORTH

0							

WEST

EAST

SOUTH

Russell

KANSAS

SEC.	TWP.	R.
8	15	13 W

WELL NO.

9 Anderson

COMPANY

FARM

Skelly Oil

CONTRACTOR

Wentworth

Hall-Gurney Pool


Ft. from N. Line

990 Ft. from S. Line

Ft. from E. Line

100 Ft. from W. Line

NW SW NW

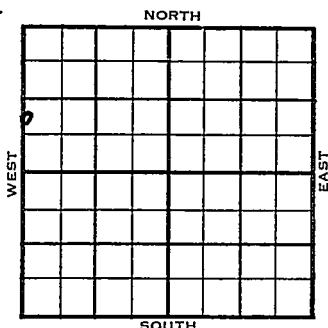

1953

ELEVATION

1767'

REPORT

9/23

Location

9/30

Anhy 745'
8" @ 755'

10/7

Heeb 2867' Tor 2885' Lans 2934'
Arb. 3229' RTD 3234' 5" @ 3230'

10/14

DD 3246 TD
5 bwph

10/28

Spud 9-23-53
Oil Well
TD 3246'
Anhy 745'
8" @ 755'
Heeb 2867', Tor 2885', Lans 2934',
Arb. 3229'
TD 3234'
5" @ 3230,
DD 3246, 5 bwph
PB 3237' 45/3226-31, 300A
16/3226-30, 300A VSSW
PB 3142 88/3122-33, 500A
1 bo 2 hrs.
PB 2904
63/2888-95, 500A, 1½ bo 2 hrs., 1500A
P/ 16 bo 1 bw 6 hrs., 2500A
Cong 3194'
Comp. 115 bopd 9% wtr.

COMPLETED

County Russell State Kansas
 Sec. 8 (Blk. 15 (Sur. 13W Map No.
 (Twp.) (Rge.)
 Operator Strelly Oil
 Well No. 9 Farm Anderson
 Elev. Location NW SW NW

0							

990 Ft. From S Line NW
100 Ft. From W Line Quarter
 1st. Report SEP 23 1953

Completion

Remarks

Wentworth - Contr.

Spudding Date

Drlg. Data

Hall-Gurney Pool

Location

J. G. McGEHEE

J. G. McGEHEE