

O. W. D. D.

KANSAS


Russell

FORM 51 5M PETROL

Section 7 Township 15 Range 13W

Well No. 6 Anderson

Company Skelly

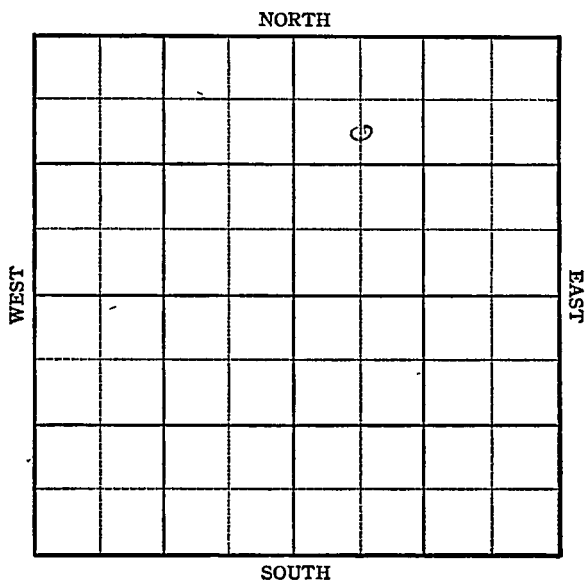

KANSAS Russell

Sec. 7 Twp. 15 R. 13-W

Well No. #6 Anderson Farm


Skelly Company

990 Ft. from N. Line

 Ft. from S. Line

 Ft. from E. Line

660 Ft. from W. Line

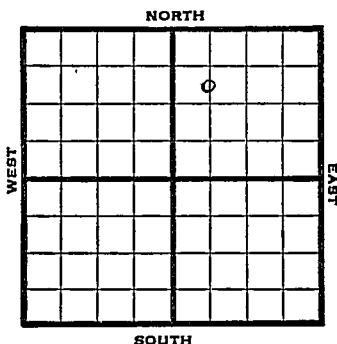

C S L NW NE

1945 Elev. 1777 , REPORT

11/14 Location

11/21 " "

11/28 RUR - - - -

12/5 Anhy. 753
8" @ 760
Drlg. 1576

12/12 Lans 2954
TD 2980
Run 5"

12/20 5" - 2970' RUST.

12/29 T.D. 3032' Swab 34 oil in 8 hours.

1946

1/9 Lans. 2954
5" @ 2970
3000 acid.
TD 3032
Pump 255 Pot.
Grav. 40.0

COMPLETED

KANSASPool Name Tra pMap No. 13 Sec. 7 Twp. 15 R. 13WWell No. 6 AndersonSkelly Company**FIRST REPORT**

Contractor

C S L NW NE

990 Ft. from N. Line Ft. from S. Line Ft. from E. Line660 Ft. from W. Line**SECTION PLAT**

		o	

Russell County

Location vRig up

Drilling and Remarks:

RECORDCased in., ft.Sand Gas Oil Total Depth **PRODUCTION**1st 24 hrs. Nat. 1st 24 hrs. after shot Gas Cu. Ft.Dry Hole Abandoned

Date

NOV 14 1945

19

S. J. LEWIS Scout

KANSAS

Kansas

Pool Name TrappMap No. 23 Sec. 7 Twp. 15 R. 13^WWell No. 6 AndersonSkelly

Company

COMPLETED

Contractor

C S L NW NE

E11777
SECTION PLAT990 Ft. from N. Line Ft. from S. Line Ft. from E. Line660 Ft. from W. Line

		o	

Russell County

Location Rig up

Drilling and Remarks:

Line 29545" C 29703000 rodsPump 255 Pk.40° E**RECORD**Cased in., ft.Sand Gas Oil Total Depth 3000**PRODUCTION**1st 24 hrs. Nat. 1st 24 hrs. after shot Gas Cu. Ft.Dry Hole Abandoned

Date

JAN 9 1946 19 S. J. LEWIS Scout

O. W. D. D

FORM 513 SUNRAY

County Russell Elev. 1777
 Sec. 7 Twp. 15 Rge. 13W
 Company Skelly Oil
 Farm Name M. E. Anderson No. 6

TOPS	DEPTH	LOG	DATUM	Loc. in Sec.
Anh.				C S ¹ NW NE
Tr.				OWDD
H.				Geol. W D D
Tr.				Contr.
Dg.				Pool
BL.				Hall-Gurney
L.	2956			
K.C.				
B.K.C.				
Ce.				
C.				
M.				
M.				
K.				
Mz.				
Me.				
V.				
S.				
S.				
A	3212			
R.				
Pe.				
G.				
T.D.				

Date Comm. 5" @ 2970 OTD 3032 DD drlg. 3226

13

County Russell Elev. 1777
 Sec. 7 Twp. 15 Rgs. 13W
 Company Skelly Oil
 Farm Name M. E. Anderson No. 6

TOPS	DEPTH	LOG	DATUM	Loc. in Sec.
Anh.				C S ¹ / ₂ NW NE
Tr.				OWDD
H.				
Tr.				
Dg.				
Bl.				
L.	2954			Geol.
K.C.				Contr.
B.K.C.				
Ce.				
C.				
M.				
M.				Pool
K.				Hall-Gurney
Mz.				
Mo.				
V.				
S.				
S.				
A.	3212			
R.				
Pe.				
G.				
TD.	3235			

Date Comm.

5" @ 2970 OTD 3032 DD drlg. 3226

FEB 20 '57 ~~ED~~ CO 3235 FU 960'

oil 4 hrs 4 1/2 c 59 @ 3235
 CO 3233 CRNL 36 / 3224-30
 12 / 3220-22 12 / 3216-18 FU
 800' oil 6 hrs no/w/1/2 \$ 50
 BO 8 hrs + Tr. wtr 1/2 P.
 88 BO + 100 wtr 8 hrs P.
 @ 150 BO + 170 wtr 15 hrs