

# KANSAS

Barton

Section 33 Township 16 Range 12W

Well No. 2 Schneweis  
1 M. Charles

Company Derby Drig.

Kraft-Prusa  
NORTH

	0						

WEST

EAST

SOUTH

KANSAS Barton


Sec. 33 Twp. 16 R. 12W ✓

Well No. #2 Schneweis  
#1 M. Charles Farm

Derby Drlg. Company

Kraft-Prusa Pool (Derby, Contr.)

NORTH

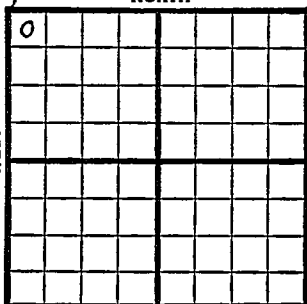

330' Ft. from N. Line

\_\_\_\_\_ Ft. from S. Line

\_\_\_\_\_ Ft. from E. Line

330' Ft. from W. Line

NW/C

SOUTH

1949

Elev 1874'

REPORT

6/1 8" @ 190'  
Anhy 772'  
Drlg. 1600'

6/7 Lansing 3077'  
Drlg. 3280'

6/15 Arb. 3327'  
5" @ 3327'  
TD 3337'  
1250 Oil 10 hrs.

6/21 "°

6/28 "

7/6 TD 3337'  
Arb. 3327'  
5" @ 3327'  
Pump 75 Oil Pot  
42° Gr.  
Comp

**COMPLETED**

Map No. \_\_\_\_\_ Sec. 33 Twp. 16 R. 12W

Well No. 1 M. Charles

Derby Drlg. \_\_\_\_\_ Company \_\_\_\_\_

Derby \_\_\_\_\_ Contractor \_\_\_\_\_

NW/C

**FIRST REPORT  
SECTION FLAT**

330 Ft. from N. Line

\_\_\_\_\_ Ft. from S. Line

\_\_\_\_\_ Ft. from E. Line

330 Ft. from W. Line

o			

Barton County

Location \_\_\_\_\_

Rig up \_\_\_\_\_

Drilling and Remarks:

8" @ 190

Anhy 772

drlg. 1600

**RECORD**

Cased \_\_\_\_\_ in., \_\_\_\_\_ ft.

Sand \_\_\_\_\_

Gas \_\_\_\_\_

Oil \_\_\_\_\_

Total Depth \_\_\_\_\_

**PRODUCTION**

1st 24 hrs. Nat. \_\_\_\_\_

1st 24 hrs. after shot \_\_\_\_\_

Gas \_\_\_\_\_ Cu. Ft.

Dry Hole \_\_\_\_\_

Abandoned \_\_\_\_\_

Date

JUN 1 1949 19 \_\_\_\_\_

S. J. LEWIS Scout

Kansas

Map No. K55 Sec. 33 Twp. 16 R. 12W

Well No. 2 Schneweis

Derby Drlg.

Company

**CORRECTION**

Contractor

NW/C

**SECTION PLAT**

330 Ft. from N. Line

\_\_\_\_\_ Ft. from S. Line

\_\_\_\_\_ Ft. from E. Line

330 Ft. from W. Line

0			

Barton County

Location \_\_\_\_\_

Rig up \_\_\_\_\_

Drilling and Remarks:

Reported as  
#1 M. Charles

**RECORD**

Cased \_\_\_\_\_ in., \_\_\_\_\_ ft.

Sand \_\_\_\_\_

Gas \_\_\_\_\_

Oil \_\_\_\_\_

Total Depth \_\_\_\_\_

**PRODUCTION**

1st 24 hrs. Nat. \_\_\_\_\_

1st 24 hrs. after shot \_\_\_\_\_

Gas \_\_\_\_\_ Cu. Ft.

Dry Hole \_\_\_\_\_

Abandoned \_\_\_\_\_

Date

JUN 8 1949 19

S. J. LEWIS Scout

Kansas

Map No. K 55 Sec. 33 Twp. 16 R. 12WWell No. 2 Schneweis

Derby Drlg. Company

COMPLETE

Contractor

NW/C

E 11874  
SECTION PLAT330 Ft. from N. Line

\_\_\_\_\_ Ft. from S. Line

\_\_\_\_\_ Ft. from E. Line

330 Ft. from W. Line

0			

Barton County

Location \_\_\_\_\_

Rig up \_\_\_\_\_

Drilling and Remarks:

*Core 3327**5" (3327)**Pump 75 oil 10'**42' - 10'*

## RECORD

Cased \_\_\_\_\_ in., \_\_\_\_\_ ft.

Sand \_\_\_\_\_

Gas \_\_\_\_\_

Oil \_\_\_\_\_

Total Depth 3327

## PRODUCTION

1st 24 hrs. Nat: \_\_\_\_\_

1st 24 hrs. after shot \_\_\_\_\_

Gas \_\_\_\_\_ Cu. Ft.

Dry Hole \_\_\_\_\_

Abandoned \_\_\_\_\_

Date

JUL 6 1949

19

S. J. LEWIS

Scout