


Section 7 Township 15 Range 13W

Well No. #5 Anderson

Company Skelly

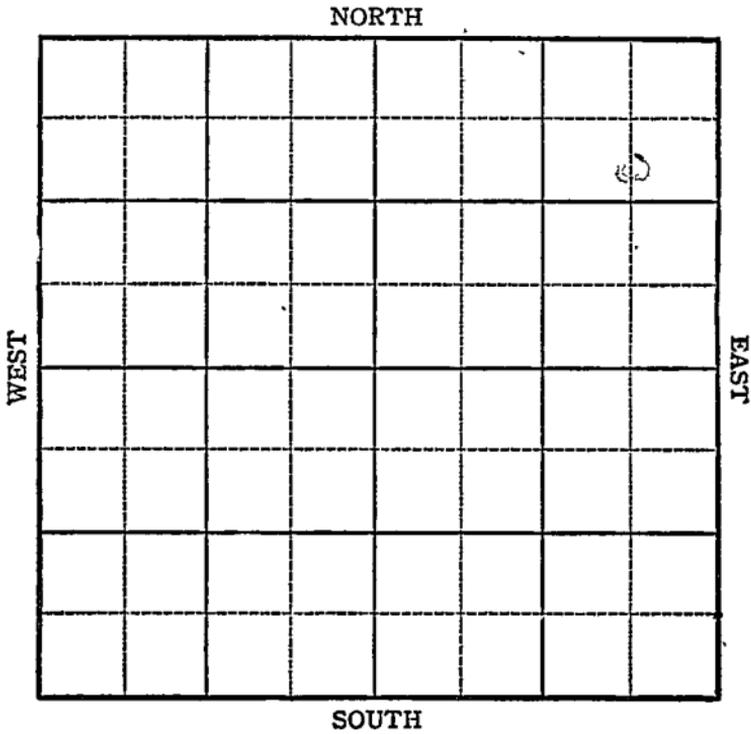

KANSAS

O. W. D. D.

Russell County

Sec. 7 Twp. 15S R. 13W

Well No. #5, Anderson Farm _____

Skelly Oil Company


Hall-Gurney

990 Ft. from N. Line

_____ Ft. from S. Line

660 Ft. from E. Line

_____ Ft. from W. Line

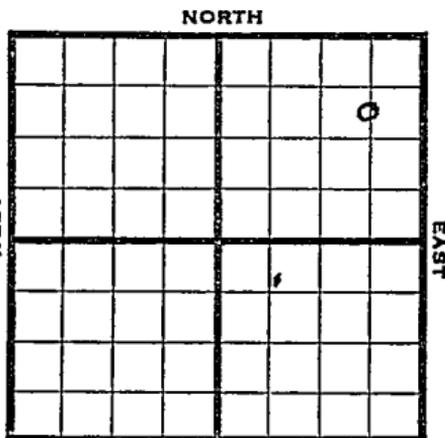

C S L NE NE

Elev. 1784 SOUTH

1945

R E P O R T

1-10	Location
1/17	Drlg 348
1/26	Anhy 755 8" @ 760' WOC
1/31	Drlg. 2035'
2/7	Drlg 2670
2/14	" "
2/21	Lans. 2958 TD 2979 5" @ 2976 RUST
2/28	" " " " " "
3/7	" " " " " "
3/14	" " " " " "
3/23	SSO 2978-2988 Drilling 3302'
3/29	TD 3019 1000 acid Flow 113 oil in 7 hrs.
4/5	250 acid flow 171 oil in 14 hrs
4/11	Lans 2958 5" @ 2976 3500 acid. TD 3019 Flow 198 Pot. Grav. 40.1

COMPLETED

OVER

1956

O. W. D. D.

8-22 Old Info; OTD 3019; 7" @ 2976;
New INFO; DD
RTD 3242;
4" liner @ 3237; 60/3222-30;
P/ 79 B0 plus 95 BW, 14 hrs.;
P/ 125 B0 plus 153 BWPD
L. 2946'; A. 3219';

FIRST REPORT

J

COMPLETED

Pool Name Hall-Gurney

Map No. 73 Sec. 7 Twp. 15 R. 13 W

Well No. 5 Anderson

Skelly Company

FIRST REPORT

Contractor

C S L NE NE

SECTION PLAT

990 Ft. from N. Line

_____ Ft. from S. Line

660 Ft. from E. Line

_____ Ft. from W. Line

			o

Russell

Location X

Rig up _____

Drilling and Remarks:

RECORD

Cased _____ in., _____ ft.

Sand _____

Gas _____

Oil _____

Total Depth _____

PRODUCTION

1st 24 hrs. Nat. _____

1st 24 hrs. after shot _____

Gas _____ Cu. Ft.

Dry Hole _____

Abandoned _____

Date

JAN 10 1945 19

S. J. LEWIS Scout

Kansas

Pool Name Hall-Gurney

Map No. 73 Sec. 7 Twp. 15 R. 13W

Well No. 5 Anderson

Skelly Company

COMPLETED Contractor

C S L NE NE

SECTION FLAT

990 Ft. from N. Line

_____ Ft. from S. Line

660 Ft. from E. Line

_____ Ft. from W. Line

			e

Russell

Elev. 1784

RECORD

Location _____

Cased _____ in., _____ ft.

Rig up _____

Sand _____

Drilling and Remarks:

Gas _____

Li mus 2958

Oil _____

5" @ 2976

Total Depth: 2919

3500 @ 3010

PRODUCTION

Flow 198 1/2

1st 24 hrs. Nat. _____

1st 24 hrs. after shot _____

Gas _____ Cu. Ft.

Dry Hole _____

Abandoned _____

40 1/2

Date

APR 11 1945

S. J. LEWIS Scout

O. W. D. D.

County Russell Elev. _____
 Sec. 7 Twp. 15S Rge. 13W
 Company Skelly Oil Co.
 Farm Name M. E. Anderson No. 5
 OWDD

TOPS	DEPTH	LOG	DATUM	Loc. in Sec.
Anb.				C S $\frac{1}{2}$ NENE
Tp.				
H.				
Tr.				
Dg.				
Bl.				
L.	2946			Geol. _____
K.C.				Contr. _____
B.K.C.				
Ce.				
C.				
M.				Pool
M.				Trapp
K.				
Mz.				
Mo.				
V.				
S.				
S.				
A	3219			
R.				
PE.				
G.				
T.D.				

AUG 22 1954
 REPORT
 COMPLETE

Date Comm. _____
 Old info - OTD 3019; 7" 2976;
 New info - DD Arb. 3219; RTD 3242; 4" liner
 at 3237; 60/3222-30; pmp 79 bo plus 95
 bw 14 hrs.; pmp 125 bo plus 153 bwpd

SEP 7 1954

(Handwritten signature/initials)