

KANSAS


Form 51-5M-7-40-Palace

Russell

Section 7 Township 15 Range 13-W

Well No. #2 Anderson

Company Skelly

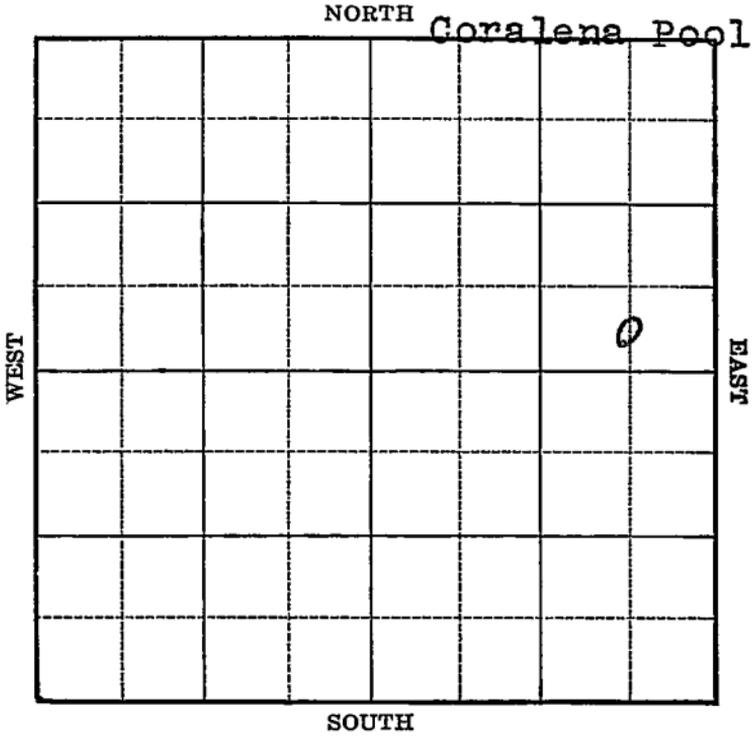

Sec. 7 Twp. 15 R. 13-W

Well No. #2 Anderson Farm

Skelly Company


(Coralena)

 Ft. from N. Line

330 Ft. from S. Line

660 Ft. from E. Line

 Ft. from W. Line

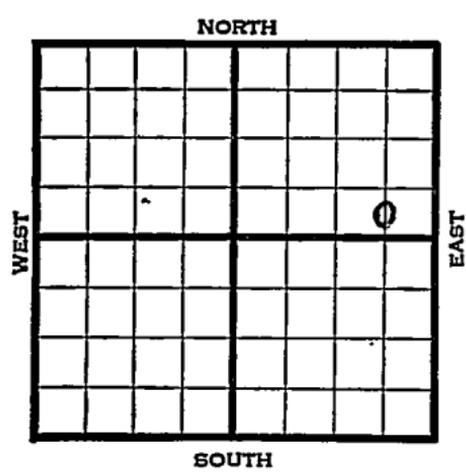

Elev. 1787

1940	REPORT
10/30	Rotary.
11/7	10" - 283' Drlg. 1470'
11/14	Drlg. 2921'
11/21	Dodge 2913' Lans. 2963'
	5" - 2981' Coring 2992'
11/27	T.D. 3012' 6000 acid.
	Pump 25 bbls. in 5 hours,
	pumped off.
12/5	TD 3063' Pump 42 water, no oil,
	3 hours. P.B.
12/12	" " "
12/18	Lans. 2963'
	5" - 2981'
	T.D. 3063'
	P.B. 3042'
	11,000 acid.
	Pump 475 oil plus 12% water.
	38.2 Gravity
	COMPLETED

Map No. 73 Sec. 7 Twp. 15 R. 13W

Well No. 2 Anderson

Skelly Company

FIRST REPORT Contractor

C S L S E N E

_____ Ft. from N. Line

330 Ft. from S. Line

660 Ft. from E. Line

_____ Ft. from W. Line

SECTION PLAT

			o

CORALENA POOL

Location _____

Rig up _____

Drilling and Remarks:

Rotary

RECORD

Cased _____ in., _____ ft.

Sand _____

Gas _____

Oil _____

Total Depth _____

PRODUCTION

1st 24 hrs. Nat. _____

1st 24 hrs. after shot _____

Gas _____ Cu. Ft.

Dry Hole _____

Abandoned _____

Date

OCT 30 1940

19

S. J. LEWIS Scout

Map No. 73 Sec. 7 Twp. 15 R. 13WWell No. 2 AndersonSkelly Oil Company

Contractor

COMPLETED

C S L SE NE

 Ft. from N. Line330 Ft. from S. Line660 Ft. from E. Line Ft. from W. LineCORAL^HMA POOL**SECTION PLAT**

Location Rig up

Drilling and Remarks:

Lian 2968
5" C 2981
P. B 3042.
11000 and
Pump .475 oil
+ 12% Water Pst
38.2 Hr

RECORDCased in., ft.Sand Gas Oil Total Depth 3063**PRODUCTION**1st 24 hrs. Nat. 1st 24 hrs. after shot Gas Cu. Ft.Dry Hole Abandoned

Date

DEC 15, 1940 19

S. J. LEWIS Scout

O. W. D. D.

FORM 513 SUNRAY

County	<u>Russell</u>	Elev.	<u>1787 DF</u>
Sec.	<u>7</u>	Twp.	<u>15</u>
		Rge.	<u>13W</u>
Company	<u>Skelly Oil Co.</u>		
Farm Name	<u>M. E. Anderson</u>	No.	<u>2</u>

TOPS	DEPTH	LOG	DATUM	Loc. in Sec.						
Anh.				C S/2 SE NE (OWDD)						
Tp.										
H.										
Tr.										
Dg.										
Bl.										
L.	<u>2961</u>			Geol.						
K.C.				Contr.						
B.K.C.										
Ce.										
C.										
M.										
M.				Pool						
K.				<u>Trapp</u>						
Mz.										
Me.										
V.										
S.				<table border="1" style="width: 100%; border-collapse: collapse;"> <tr> <td colspan="2" style="text-align: center;">FIRST REPORT</td> </tr> <tr> <td style="text-align: center;">MAY 29 '57</td> <td style="text-align: center;">o</td> </tr> <tr> <td colspan="2" style="text-align: center;">COMPLETE</td> </tr> </table>	FIRST REPORT		MAY 29 '57	o	COMPLETE	
FIRST REPORT										
MAY 29 '57	o									
COMPLETE										
S.										
A.										
R.										
PE.										
G.										
TD.	<u>OTD</u>	<u>3009</u>								

Date Comm. 5" @ 2981 - New Info - RUCT & DD, Arb. 3248, TD 3268. 4" liner to 3268, 43/3249-51, 250A, P/133 bo + 7 bw 20 hrs. - Comp.

13

Co. Lse. No. Sec. T. R.