

KANSAS

Form 51-5M-11-38-Palace

Russell

Section 8 Township 15 Range 13-W

Well No. #6 Rein


Company Skelly

Coralena Pool

NORTH

WEST

EAST

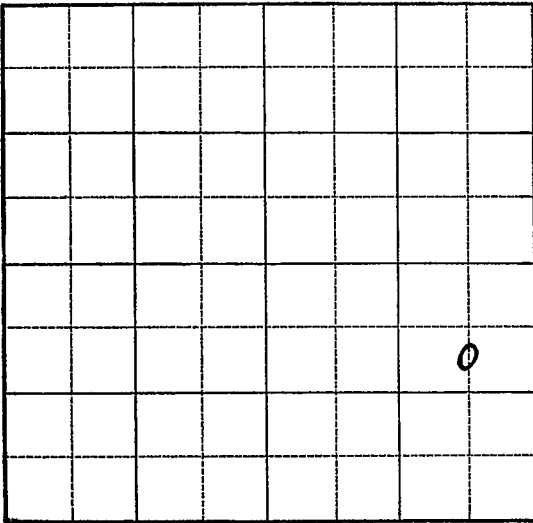

SOUTH

Russell

Sec. 8 Twp. 15 R. 13-W

Well No. #6 Rein Farm _____

Skelly Company

(Coralena)


990 Ft. from N. Line

Ft. from S. Line

660 Ft. from E. Line

Ft. from W. Line

Elev. 1870

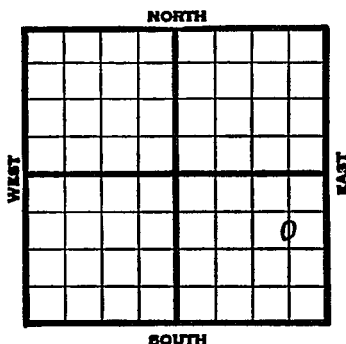[illegible]

Russell

KANSAS

Map No. 72 Sec. 8 Twp. 15 R. 13WWell No. 6 ReinSkelly

Company

Contractor

FIRST REPORT

C S L N E S E

SECTION PLAT

			o

990 Ft. from N. Line Ft. from S. Line660 Ft. from E. Line Ft. from W. Line

CORALENA POOL

Location Rig up

Drilling and Remarks:

Rotary

RECORD

Cased in., ft.Sand Gas Oil Total Depth

PRODUCTION

1st 24 hrs. Nat. 1st 24 hrs. after shot Gas Cu. Ft.Dry Hole Abandoned

Date

NOV 3 1939

LEWIS

Scout

Russell

KANSAS

Map No. 73 Sec. 8 Twp. 15 R. 13WWell No. 6 ReinSkelly

Company

Contractor

COMPLETED

C S I NE SE

990 Ft. from N. Line Ft. from S. Line660 Ft. from E. Line Ft. from W. Line

SECTION PLAT

CORALENA POOL

Location Rig up

Drilling and Remarks:

*Lions 3023**7" @ 3048**4000 amol**1092 "**Flow 2054 Psf**3.5/8 AM Gas.*

RECORD

Cased in., ft.Sand Gas Oil Total Depth 3064

PRODUCTION

1st 24 hrs. Nat. 1st 24 hrs. after shot Gas Cu. Ft.Dry Hole Abandoned

Date

DEC 20 1939

19

S. J. LEWIS

Scout