


Section 7 Township 15 Range 13 W

Well No. # 4 Maag

Company Great Lakes Carbon

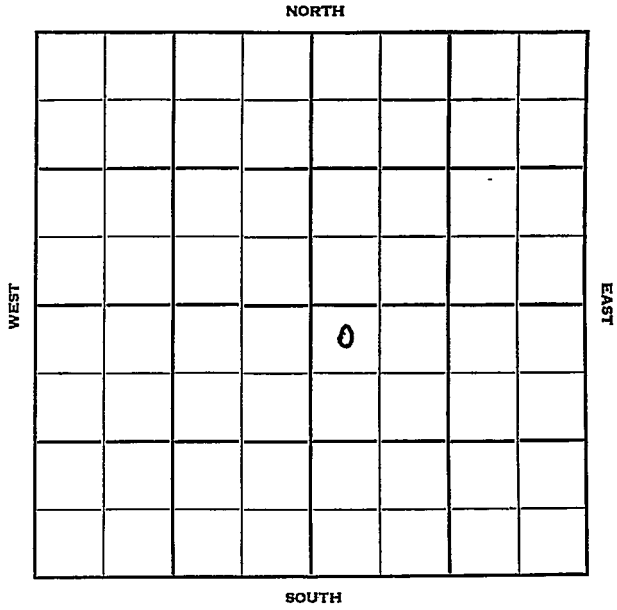

Sec. 7 Twp. 15 R. 13W

Well No. #4 Maag Farm

Great Lakes Carbon Company


Gabbert-Jones Contractor  
Trapp Pool

330 Ft. from N. Line

\_\_\_\_\_ Ft. from S. Line

\_\_\_\_\_ Ft. from E. Line

330 Ft. from W. Line

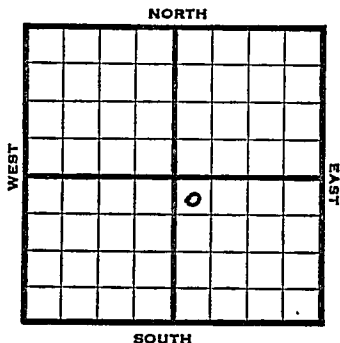

NW NW SE

1953 Elev. 1856' REPORT

5/20 Spud 5-18-53  
Surface Set

5/28 8" @ 290'  
Drlg 2712'

6/3 Spud 5-18-53  
D & A  
TD 3326'  
8" @ 290'  
Anhy 890, Tarkio 2397, Heeb 2967, Tor 2986,  
DS<sup>T</sup> 3059-65 opn 1 hr, rec 12' mud  
KC 3037,  
DS<sup>T</sup> 3069-80 opn 3/4 hr, rec 6' mud  
O# Cong 3311, Arb 3321  
TD 3326  
D & A

**ABANDONED**



