Barton KANSAS

SECTION 34 TOWNSHIP 16 RANGE 12 W

WELL NO. #2 Feltes

COMPANY Shields Oil Prod.

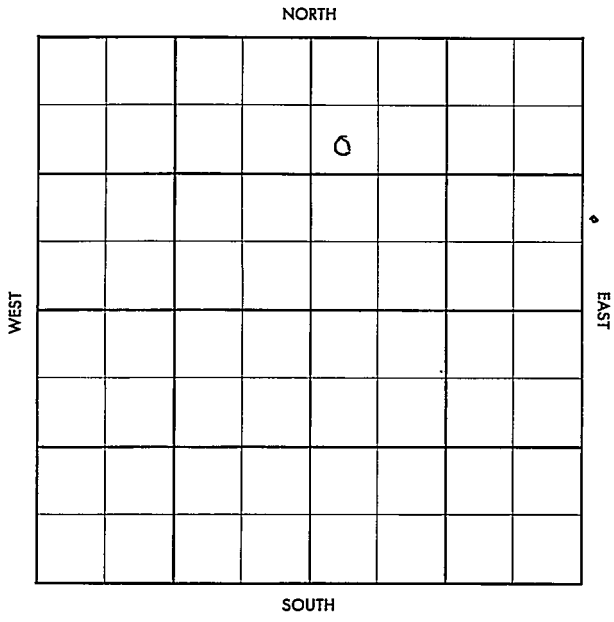

FORM 504-3 SUNRAY

Barton KANSAS

SEC.	TWP.	R.
34	16	12W

WELL NO.

#2 Feltes FARM

COMPANY

Shields Oil Prod.

CONTRACTOR

Co. Tools

S.Beaver

_____ Ft. from N. Line

_____ Ft. from S. Line

_____ Ft. from E. Line

_____ Ft. from W. Line

SW NW NE

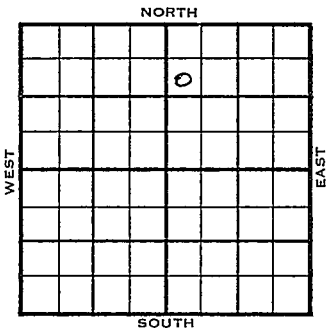

1955	ELEVATION 1893' REPORT
12-7	Location
1956	
2-8	Comm. 1-10-56 8 5/8" @ 200 5½" @ 3410 MICT DD 3530 Anh. 780 Tp. 2684 H. 2970 Tr. 2987 BL. 3060 L. 3077 C. 3337 A. 3367 TD ~~3525~~' 3530'

ABANDONED

DX-78

FORM 513 REV. SUNRAY

County Barton Elev.

Sec. 31 Twp. 16S Rge. 12W

Company Shields Oil Prod.

Farm Name Feltes No. 2

TOPS	DEPTH	LOG	DATUM
Anh.			
Tp.			
H.			
Tr.			
Dg.			
B.L.			
L.			
K.C.			
B.K.C.			
Ce.			
C.			
M.			
M.			
K.			
Mz.			
Mg.			
V.			
S.			
S.			
A			
R.			
P€.			
G.			
T.D.			

Loc. in Sec. SW NW NE

Geol.

Contr. Co. tools

Pool S. Beaver

6

FIRST REPORT

DEC 7 55

Date Comm.

Location

Co.

Lse.

No.

Sec.

T.

R.

FORM 513 REV SUNRAY

County Barton Elev. 1893

Sec. 34 Twp. 16 Rge. 12W

Company Shields Oil Prod.

Farm Name Feltes No. 2

TOPS	DEPTH	LOG	DATUM
Anh.	780		
Tp.	2684		
H.	2970		
Tr.	2987		
Dg.			
Bl.	3060		
L.	3077		1184
K.C.			
B.K.C.			
Ce.			
C.	3337		1444
M.			
M.			
K.			
Mz.			
Mc.			
V.			
S.			
S.			
A	3367		1474
R.			
Pe.			
G.			
T.D.	3525		

Loc. in Sec. SW NW NE

Geol.

Contr. Co. tools

Pool S. Beaver



Date Comm. FEB 8 1956

Location DEC 14 '55 ✓ DEC 21 '55 DEC 28 '55

JAN 5 '56 JAN 11 '56 RUR JAN 18 '56 1-10-56

8 5/8 200 Ø 2840 JAN 25 '56 5½ @

3410 FEB 1 '56 MICT FEB 8 '56 DD 3530

(2)

SWD