
Form 51 5M 11-23 13896

Map No. Kansas Sec. 8 Twp. 12 R. 15 W

Well No. 3 Oswald Farm

Midwest Company

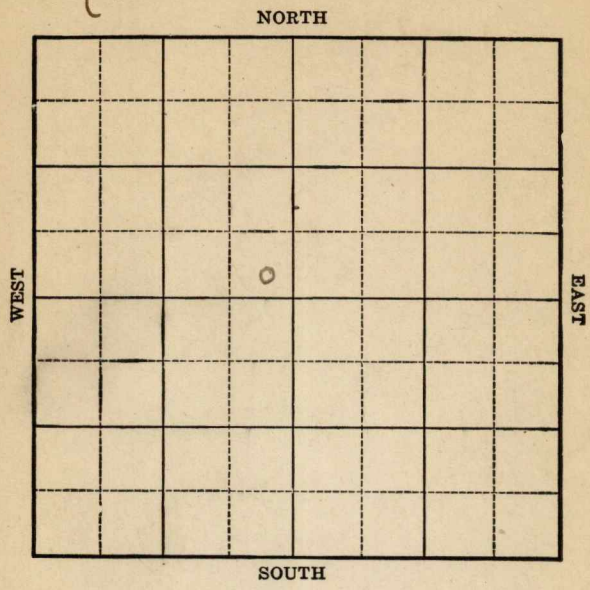

Location _____

Drilling Remarks:

Rig Up _____

Drilling Remarks:

RECORD

Cased _____ in. _____ ft.

Sand _____

Gas _____

Oil _____

Total Depth _____

PRODUCTION

1st 24 hrs. Nat. _____

1st 24 hrs. after shot _____

Gas _____ cu. ft.

Dry Hole _____

Abandoned _____


Form 252A 5M 8-24 16529

Russell

Map No. Kansas Sec. 8 Twp. 12 R 15 W

Well No. 3 Oswald Farm

Midwest Company

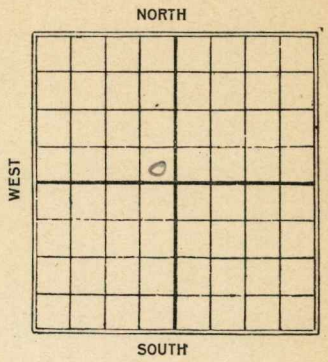

Ft. from N. Line

330 Ft. from S. Line

330 Ft. from E. Line

Ft. from W. Line

B

Date	REPORT
1/25	
4/28	Rig up
6/2	1485
9/2	F 2903 Qal 2920
	T.D. 2943
	110 Bbls nat

Form 26—1M Bks.—3-23—11959.

Map No. KANSAS Sec. 8 Twp. 12 R. 15W Russell


Well No. 3 Oswald.

Midwest Company

Contractor

FIRST REPORT

SECTION PLAT

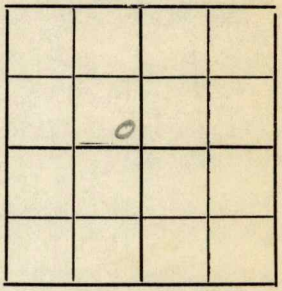

_____Ft. from N. Line

330 Ft. from S. Line

330 Ft. from E. Line

_____Ft. from W. Line

Location _____

Rig up _____

Drilling and Remarks:

RECORD

Cased_____in., _____ ft.

Sand _____

Gas _____

Oil _____

Total Depth _____

PRODUCTION

1st 24 hrs. Nat. _____

1st 24 hrs. after shot _____

Gas _____Cu. Ft.

Dry Hole _____

Abandoned _____

Date APR 28 1925

_____192___.

M. A. BENEAR

_____Scout

Form 26—1M Bks.—3-23—11959.

Russell Co. Kans


Map No. [illegible] Sec. 8 Twp. 12 R. 15 W

Well No. 3 Oswalt

Mid-West Co. Company

Contractor

SECTION PLAT

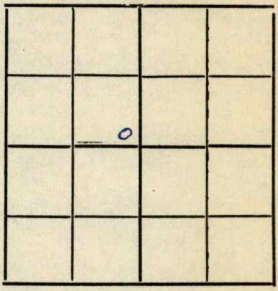

330 Ft. from N. Line

330 Ft. from S. Line

330 Ft. from E. Line

Ft. from W. Line

COMPLETED

Location

Rig up

Drilling and Remarks:

TS. 2903
2920 oil
TJ 2943
1108 Ls Nat.

RECORD

Cased in., ft.

Sand

Gas

Oil

Total Depth

PRODUCTION

1st 24 hrs. Nat.

1st 24 hrs. after shot

Gas Cu. Ft.

Dry Hole

Abandoned

Date

SEP 2 1925

192

S. J. LEWIS

Scout