Barton KANSAS

SECTION 34 TOWNSHIP 16 RANGE 12 W

WELL NO. #3 Feltes

COMPANY Shield

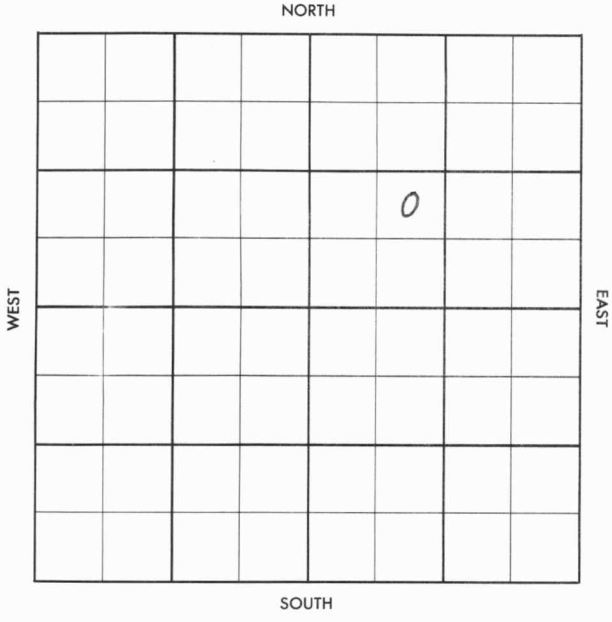

FORM 504-3 SUNRAY

Barton KANSAS

SEC.	TWP.	R.
34	16	12W

WELL NO.

#3 Feltes FARM

COMPANY

Shield

CONTRACTOR

Co. tools

S. Beaver

_____ Ft. from N. Line

_____ Ft. from S. Line

_____ Ft. from E. Line

_____ Ft. from W. Line

NE SW NE

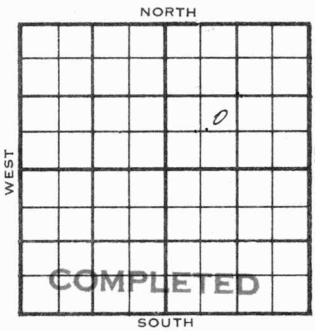

1956	ELEVATION	REPORT
1-25		Comm. 1-23-56 8" @ 200 WOC

DX-78

FORM 513 REV. SUNRAY

County Barton Elev.

Sec. 34 Twp. 16 Rge. 12W

Company Shield

Farm Name Feltes No. 3

TOPS	DEPTH	LOG	DATUM
Anh.			
T.p.			
H.			
Tr.			
Dg.			
B.L.			
L.			
K.C.			
B.K.C.			
Ce.			
C.			
M.			
M.			
K.			
Mz.			
Mq.			
V.			
S.			
S.			
A			
R.			
P€.			
G.			
T.D.			

Loc. in Sec. NE SW NE

Geol.

Contr. Co. tools

Pool S. Beaver



Date Comm. 1-23-56

8" @ 200 WOC

Co. Lse. No. Sec. T. R.

3

FORM 513 REV. SUNRAY

County Barton Elev. 1875 DF 1879 RB

Sec. 34 Twp. 16 Rge. 12W

Company Shield

Farm Name Feltes No. 3

TOPS	DEPTH	LOG	DATUM
Ank.			
Tp.	2665		
H.	2951		
Tr.	2965		
Dg.	2978		
Bl.	3040		1161
L.	3057		1178
K.C.			
B.K.C.			
Ce.			
C.	3321		1442
M.			
M.			
K.			
Mc.			
Mc.			
V.			
S.			
S.			
A	3334		1455
R.			
PC.			
G.			
T.D.	3338		

Loc. in Sec. NE SW NE

1540 NL

Geol.

Contr. Co. tools

Pool S. Beaver

COMPLETE

Date Comm. 1-23-56 MAR 7 1956

8" @ 200 WOC FEB 1 '56 DST 3045-91

1hr 820' gas rec 140' SO&GCM +

240' HOCM + 180' Mdy oil BHP 990/20

HP 3100 FEB 8 '56 4½ 3336/100

FEB 15 '56 CO 3338 RTP FEB 22 '56 $

10 Bopd + 10% wtr 3 hrs

POP FEB 29 '56 ✓ MAR 7 '56 P. 15 Bopd

+ 10% wtr

Co. Lse. No. Sec. T. R.