

Well No. 2 Maag

Trapp
NORTH

	0						
		.					

SOUTH

KANSAS

Sec. ~~17~~ 7 Twp. 15 R. 13W ✓

Well No. #2 Maag Farm

Derby Oil

Company


Trapp Pool

330' Ft. from N. Line

_____ Ft. from S. Line

_____ Ft. from E. Line

990' Ft. from W. Line

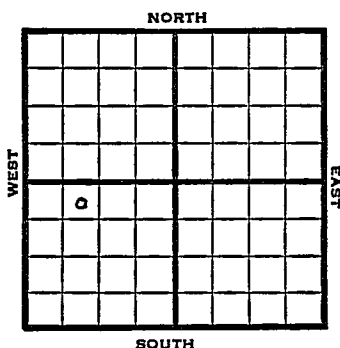

NE NW SW

1949 Elev 1873' REPORT

4/6 RUR
4/12 8"@ 447'
Drlg 2170'
4/20 Lansing 3050'
Arb. 3316'
TD 3319
4"@ 3319'
4/27 TD 3324
Swb 23 bbls oil PH 3 hrs.
5/4 "
5/10 "
5/18 TD 3324'
Arb 3316'
4"@ 3319'
Pump 464 Pot oil
40⁹ Gr.
Comp

COMPLETED

Map No. _____ Sec. 17 Twp. 15 R. 13W

Well No. 2 Maag

Derby Oil Company

FIRST REPORT Contractor

NE NW SW

SECTION PLAT

330 Ft. from N. Line

_____ Ft. from S. Line

_____ Ft. from E. Line

990 Ft. from W. Line

o			

Russell County

Location _____

Rig up _____

Drilling and Remarks:

R U R

RECORD

Cased _____ in., _____ ft.

Sand _____

Gas _____

Oil _____

Total Depth _____

PRODUCTION

1st 24 hrs. Nat. _____

1st 24 hrs. after shot _____

Gas _____ Cu. Ft.

Dry Hole _____

Abandoned _____

Date

APR 6 1949 19 S. J. LEWIS Scout

Map No. 73 Sec. 7 Twp. 15 R. 13W

Well No. 2 Maag

Derby Oil. Company

CORRECTION Contractor

NE NW SW

SECTION PLAT

330 Ft. from N. Line

 Ft. from S. Line

 Ft. from E. Line

990 Ft. from W. Line

Russell County

Location

Rig up

Drilling and Remarks:

Reported
17-15-13W

RECORD

Cased in., ft.

Sand

Gas

Oil

Total Depth

PRODUCTION

1st 24 hrs. Nat.

1st 24 hrs. after shot

Gas Cu. Ft.

Dry Hole

Abandoned

Date

APR 13 1949

19

S. J. LEWIS

Scout

Kansas

Trapp Pool

Map No. K73 Sec. 7 Twp. 15 R. 13WWell No. 2 Maag

Derby Oil

Company

COMPLETE

Contractor

NE NW SW

E1/182

SECTION PLAT

330

Ft. from N. Line

Ft. from S. Line

Ft. from E. Line

990

Ft. from W. Line

o			

Russell County

Location

Rig up

Drilling and Remarks:

*Ar 3316**4" C 3318**Prod 464 P 7**40 9/16*

RECORD

Cased _____ in., _____ ft.

Sand _____

Gas _____

Oil _____

Total Depth *C 3324*

PRODUCTION

1st 24 hrs. Nat. _____

1st 24 hrs. after shot _____

Gas _____ Cu. Ft.

Dry Hole _____

Abandoned _____

Date

MAY 18 1949

19

S. J. LEWIS Scout