

KANSAS

FORM 51 5M 10-41 PETROL


Russell

Section 7 Township 15 Range 13-W

Well No. #1 Maag

Company Great Lakes Carbon

Coralena Pool NORTH

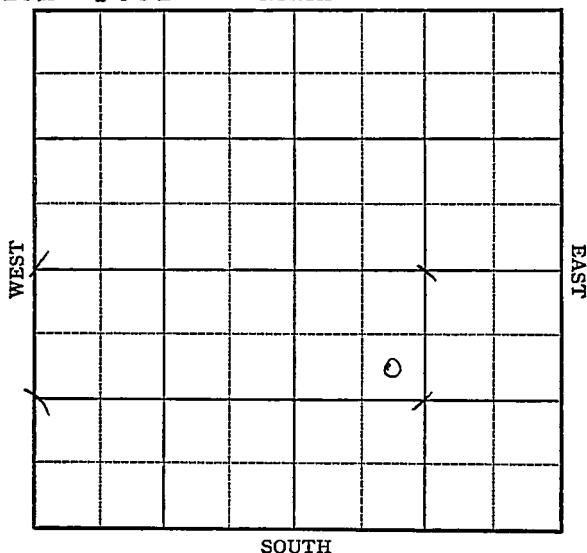

KANSAS


Russell

Sec. 7 Twp. 15 R. 13WWell No. 1-Maag FarmGreat Lakes Carbon Company

(Coralena pool)

990 Ft. from N. Line Ft. from S. Line Ft. from E. Line990 Ft. from W. Line

Elev. 1826

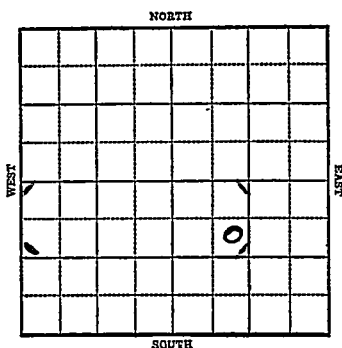

1942

R E P O R T

9/30	Spud
10/7	10" - 457 Anhy 807 Drlg. 2194
10/14	Topoka 2690 Sab. 2876-99 Lans. 2995 Sab. 3017-20, 3032-34, 3887-99 Drlg. 3151
10/21	BKC 3250 Arb 3263 5" @ 3263 TD 3269 2800' oil
10/28	" "
11/4	" "
11/11	" "
11/18	Swabb 20 oil per hr. - 500 acid.
11/24	" " "
12/9	" " "
12/16	Echo Pob 852 to perforate the Lansing.
12/22	Arb. 3263 5" @ 3263' T.D. 3269' 500 gals. acid Echo Pot. 852 Gravity 40

COMPLETED

Russell.

Map No. 73 Sec. 7 Twp. 15 R. 13W

Well No. 1 Maag

Great Lakes Carbon Company

Contractor

SE NW SE


SECTION PLAT

990 Ft. from N. Line

_____ Ft. from S. Line

_____ Ft. from E. Line

990 Ft. from W. Line

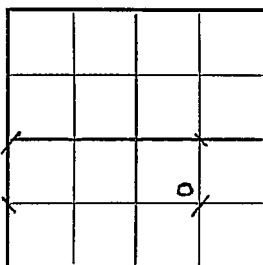

CORALENA POOL

Location _____

Rig up _____

Drilling and Remarks:

Spud

RECORD

Cased _____ in., _____ ft.

Sand _____

Gas _____

Oil _____

Total Depth _____

PRODUCTION

1st 24 hrs. Nat. _____

1st 24 hrs. after shot _____

Gas _____ Cu. Ft.

Dry Hole _____

Abandoned _____

Date

FIRST REPORTS

SEP 30 1942 19

S. J. LEWIS

Scout

Please show this company's acreage.
We show Carter & Cities Service have drilled
on SE/4. Don Schumaker

Misc. Small Maps	<i>MS</i>
Cards	
Tracing	<i>MS</i>
France Map	<i>MS</i>
Scarborough Map	
Moody Map	<i>MS</i>
Geological Dept.	
Moody Flat Book	

KANSAS

Russell

Map No. 73 Sec. 7 Twp. 15 R. 13WWell No. 1 ¹¹¹Maag


Great Lakes Carbon Company

COMPLETED

Contractor

SE NW SE

SECTION PLAT

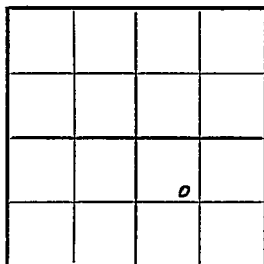990 Ft. from N. Line Ft. from S. Line Ft. from E. Line990 Ft. from W. Line

TRAP P POOL

Location

Rig up

Drilling and Remarks:


RECORD

Cased in., ft.Sand Gas Oil Total Depth 3269

PRODUCTION

1st 24 hrs. Nat. 1st 24 hrs. after shot Gas Cu. Ft.Dry Hole Abandoned

Date

DEC 22 1942

S. J. LEWIS

Scout