

Section 7 Township 15 Range 13W

Well No. #1 Maag

Company Derby

Trapp

NORTH

WEST

EAST

6							

SOUTH

KANSAS


Russell R. 13W ✓

Sec. 7 Twp. 15

Well No. #1 Maag Farm

Derby Company

Trapp Pool

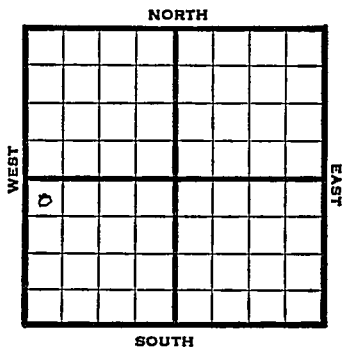

330' Ft. from N. Line

_____ Ft. from S. Line

_____ Ft. from E. Line

330' Ft. from W. Line

NW SW

1948

Elev. 1874' REPORT

1/7 Location

1/14 8" @ 440'
WOC

1/21 Drlg. 2840'

1/26 Lansing 3020'
Arbuckle 3321-26'
TD 3326'
5" @ 3320'
RUST

2/4 "

2/11 TD 3345' - 500 acid
Swab 7 bbls. oil PH 8 hrs.

2/18 "

2/25 Arb. 3321'
5" @ 3320'
Pump 150 Pot
40.9 Gr.
TD 3345'
Comp.

COMPLETED

Map No. _____ Sec. 7 Twp. 15 R. 13W

Well No. 1 Maag

Derby

Company _____

FIRST REPORT

Contractor _____

NW SW

SECTION PLAT

330 Ft. from N. Line

o			

_____ Ft. from S. Line

_____ Ft. from E. Line

330 Ft. from W. Line

Russell County

Location X

RECORD

Rig up _____

Cased _____ in., _____ ft.

Drilling and Remarks:

Sand _____

Gas _____

Oil _____

Total Depth _____

PRODUCTION

1st 24 hrs. Nat. _____

1st 24 hrs. after shot _____

Gas _____ Cu. Ft.

Dry Hole _____

Abandoned _____

Date

JAN 7 1948 19

S. I. LEWIS Scout

Map No. 73 Sec. 7 Twp. 15 R. 13W

Well No. 1 Maag

Derby Company

COMPLETE

Contractor

NW SW

E. 11874
SECTION PLAT

330 Ft. from N. Line

 Ft. from S. Line

 Ft. from E. Line

330 Ft. from W. Line

△			

Russell County

Location

Rig up

Drilling and Remarks:

Cell 3321

5' @ 2320

Pump 150 Bb

40 lbs

RECORD

Cased in., ft.

Sand

Gas

Oil ✓

Total Depth 3345'

PRODUCTION

1st 24 hrs. Nat.

1st 24 hrs. after shot

Gas Cu. Ft.

Dry Hole

Abandoned

Date

FEB 25 1948

19

S. J. LEWIS

Scout